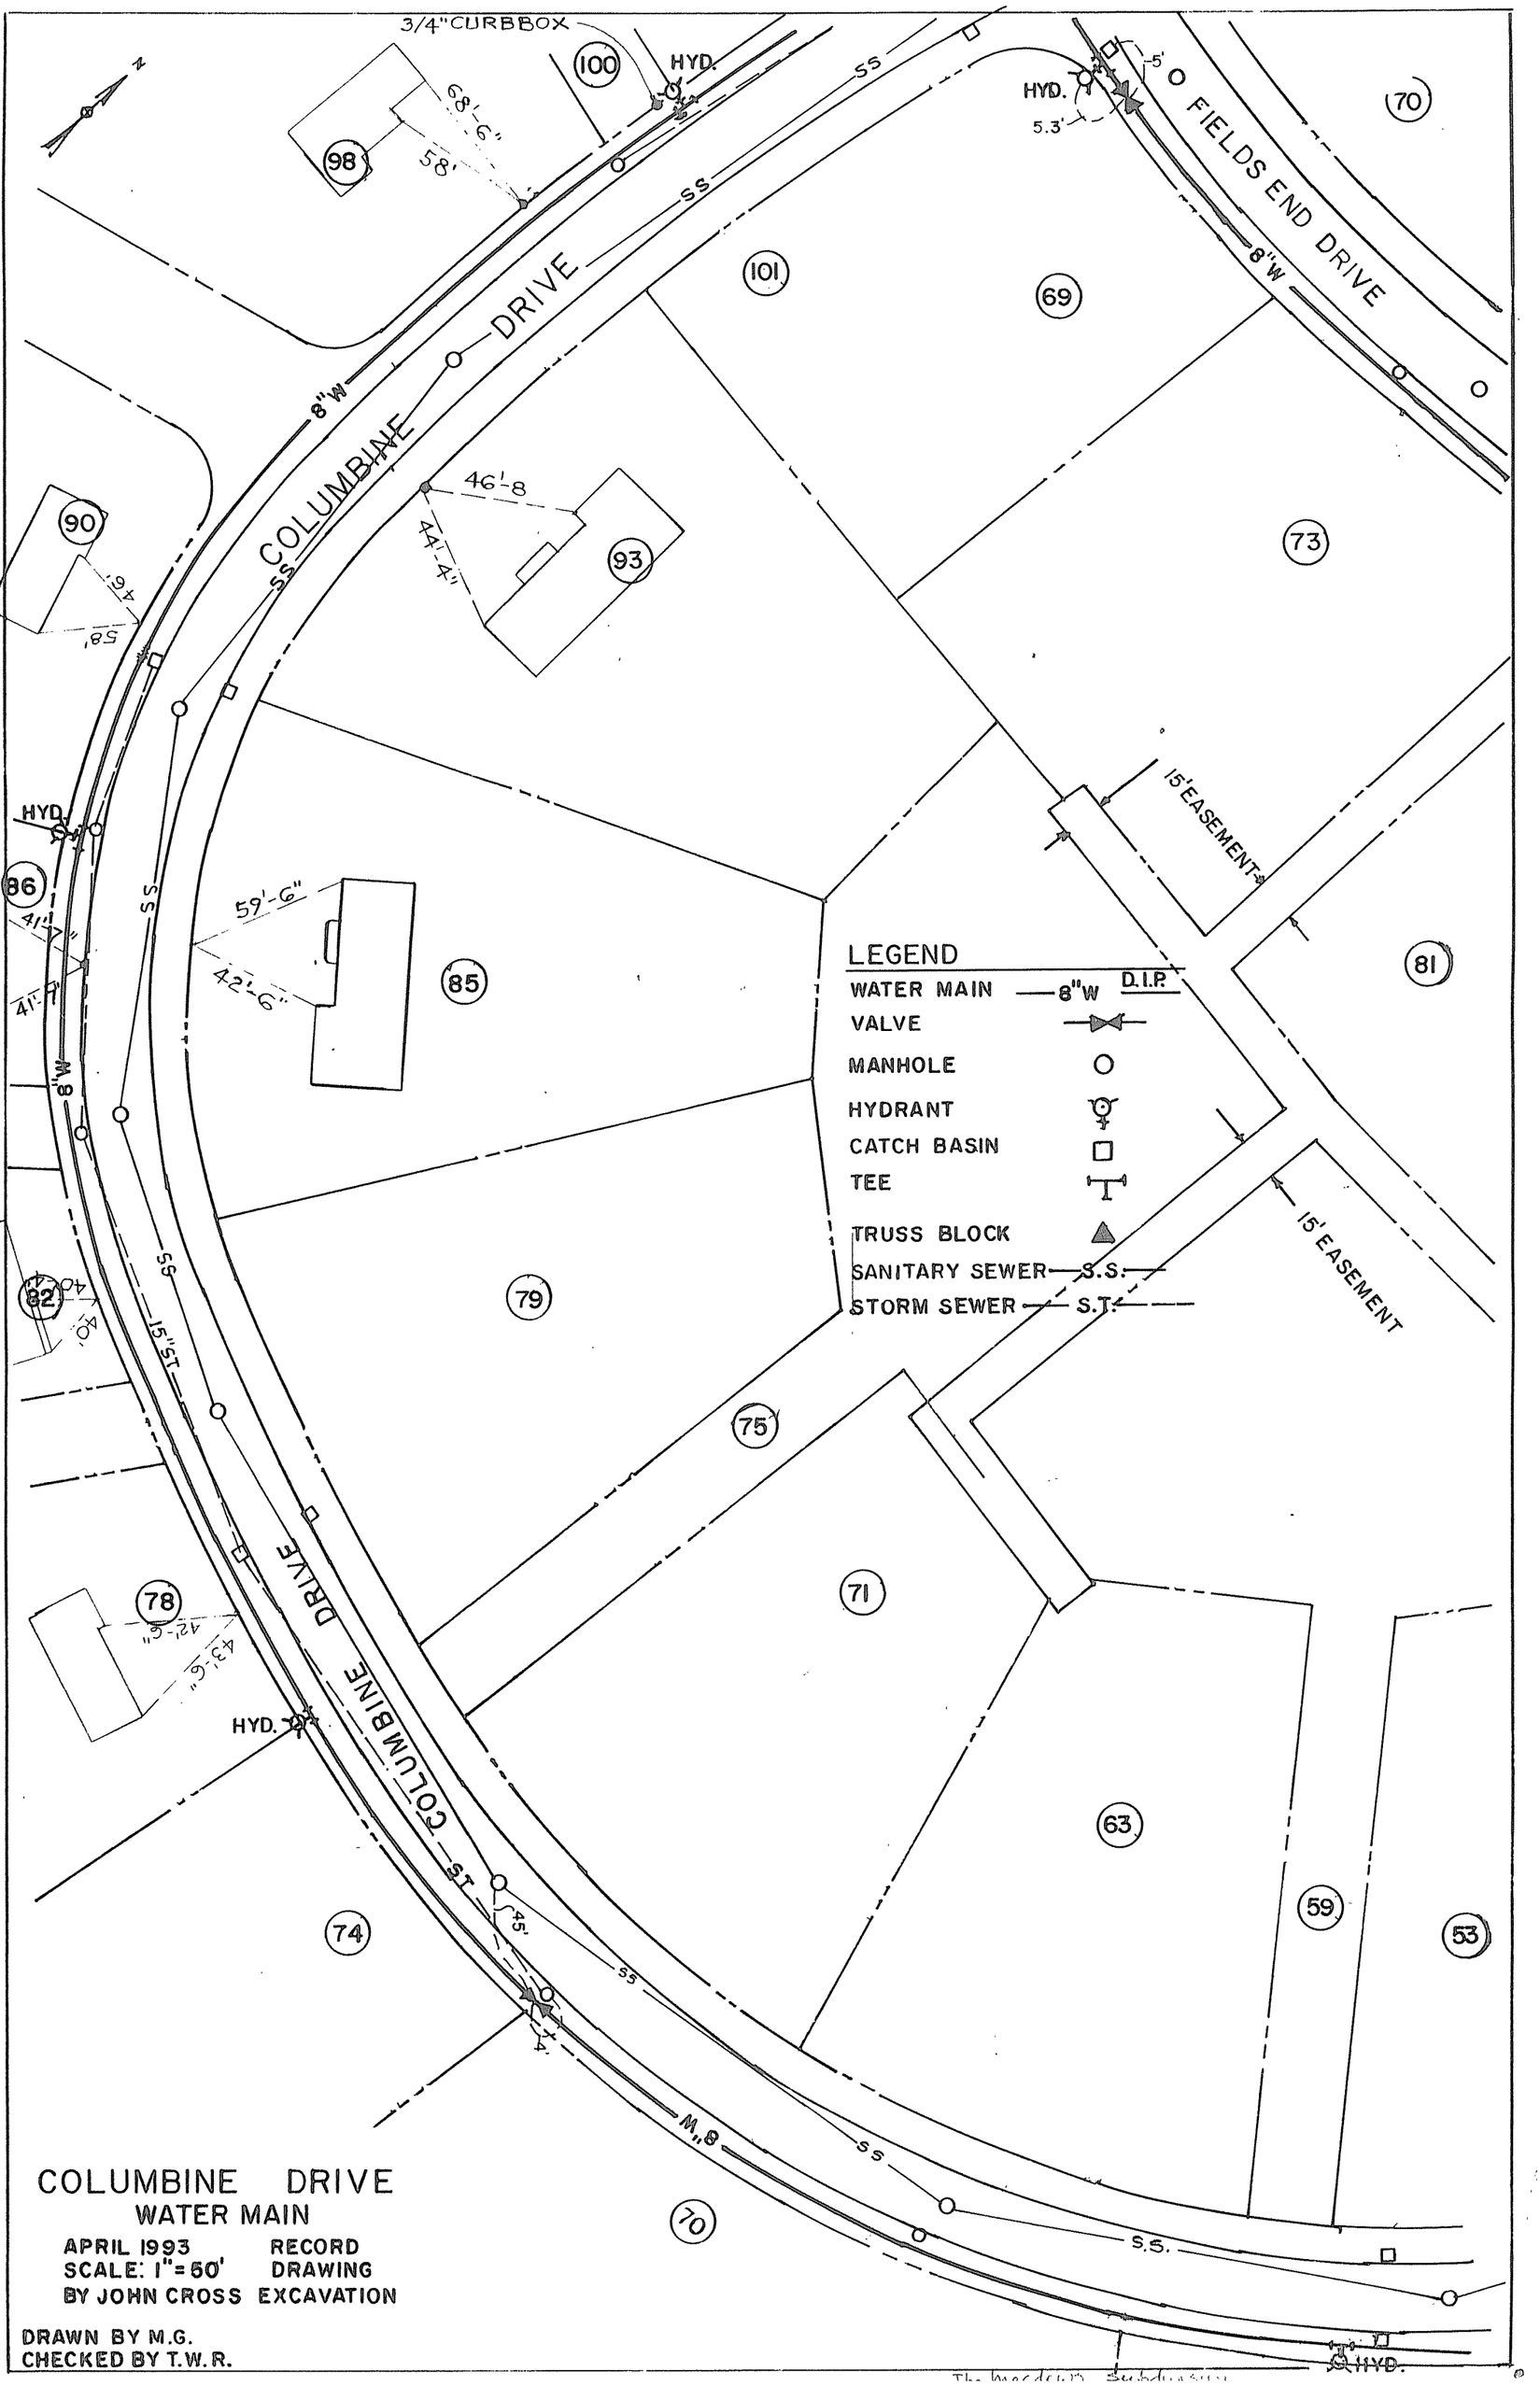

COLUMBINE DRIVE
WATER MAIN

APRIL 1993 RECORD
SCALE: 1" = 50' DRAWING
BY JOHN CROSS EXCAVATION

DRAWN BY M.G.
CHECKED BY T.W.R.