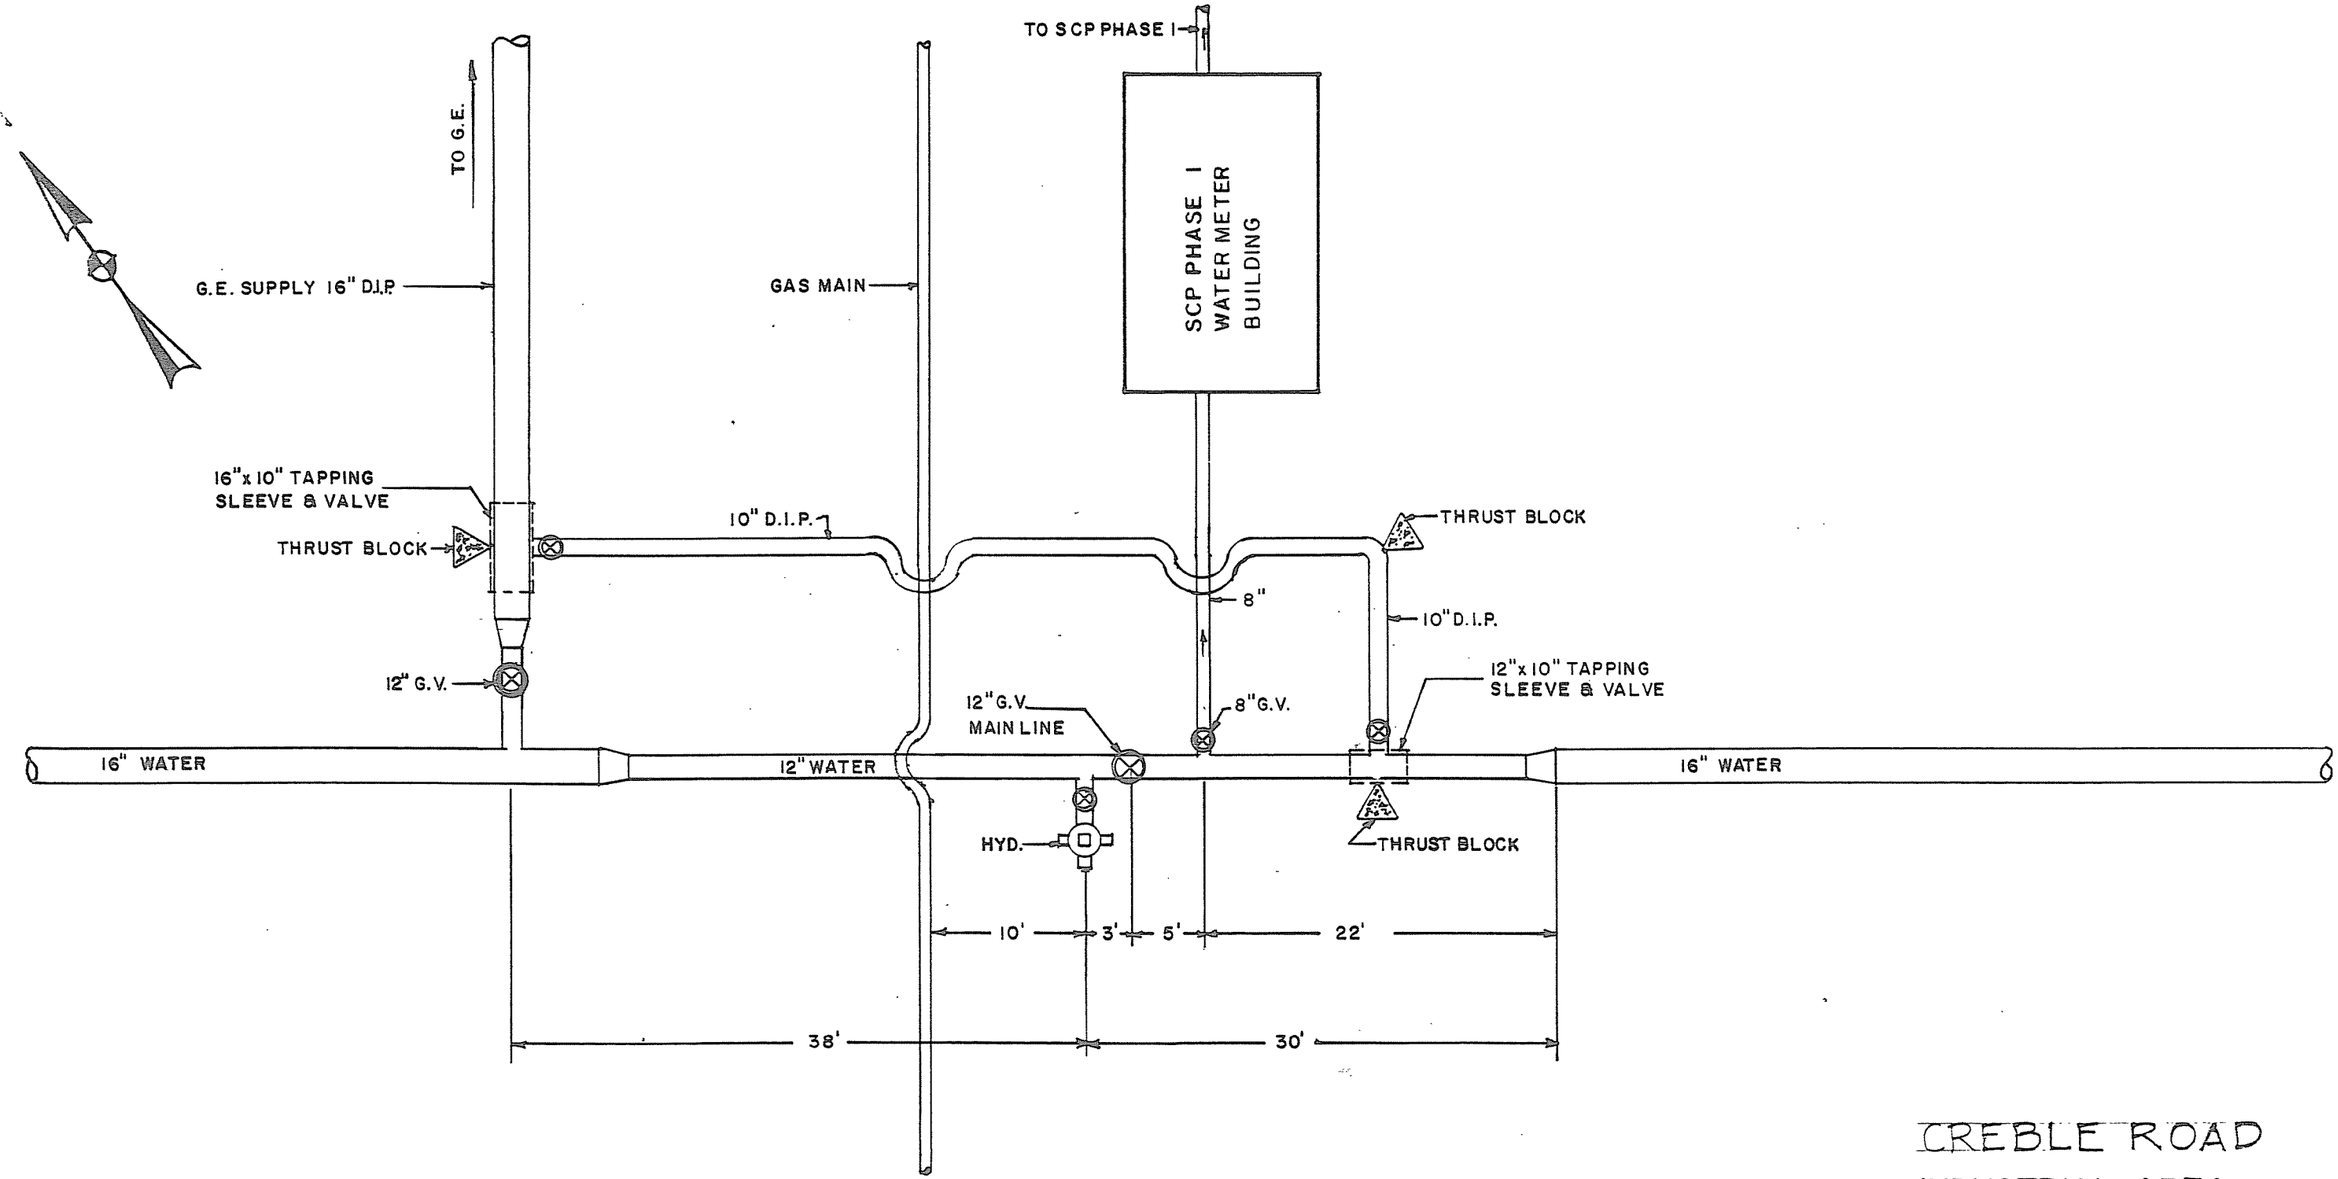

WEST (CREBLE ROAD) EAST

CREBLE ROAD

INDUSTRIAL AREA
FEURA BUSH EXTENSION
WATER DISTRICT No. I
TOWN OF BETHLEHEM
SERVICE CONNECTION FOR
G.E. PLASTICS
RECORD OF INSTALLATION
NOSCALE DATE: DEC. 1993

TOWN OF BETHLEHEM
ENGINEERING DIVISION
445 DELAWARE AVE. DELMAR, NEW YORK 12054

M.G.