DANIEL STREET
CALDWELL BLVD

WATER DISTRICT NO. 1
TOWN OF BETHLEHEM

RECORD OF INSTALLATION

TOWN OF BETHLEHEM ENGINEERING DEPARTMENT

SCALE : 1" = 50' JUNE, 1984
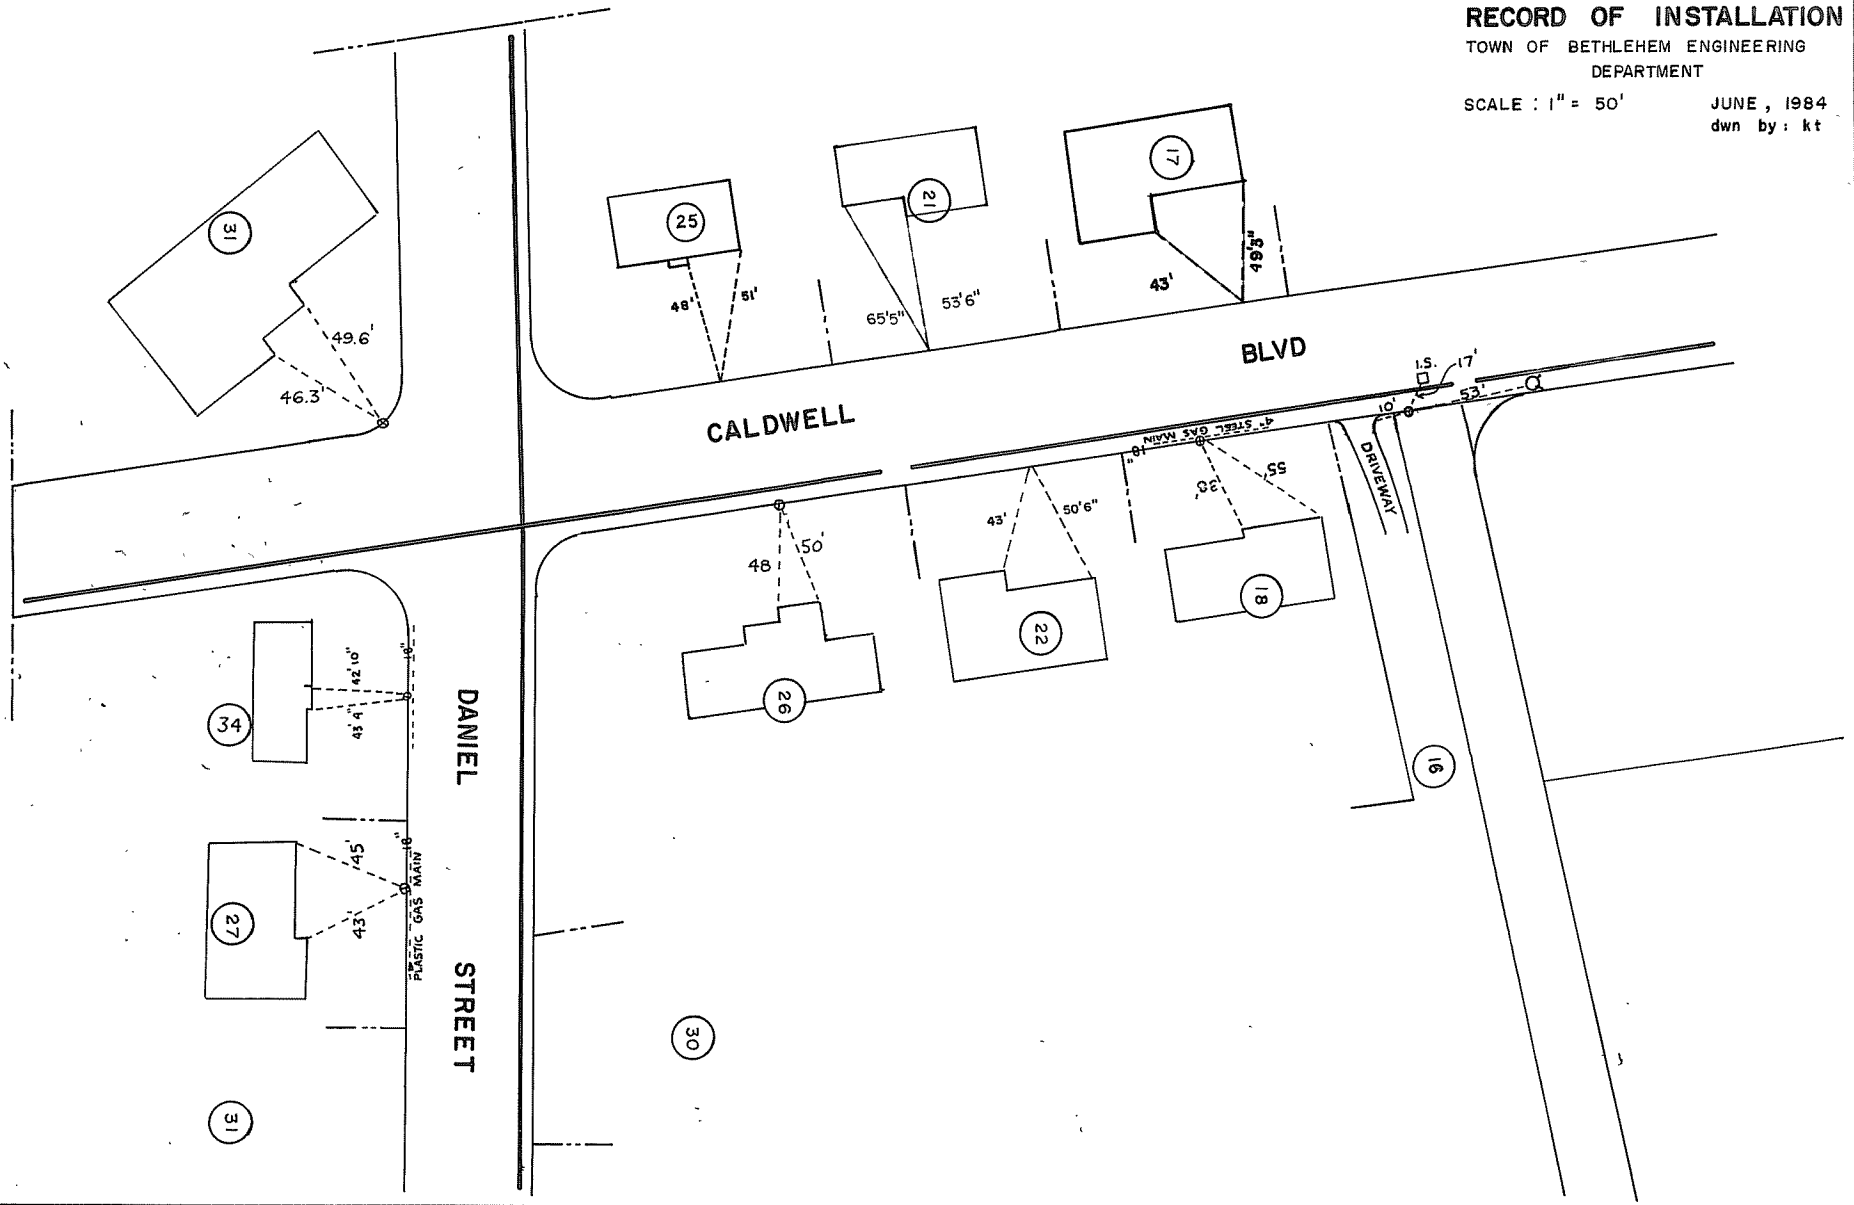
dwn by : kt