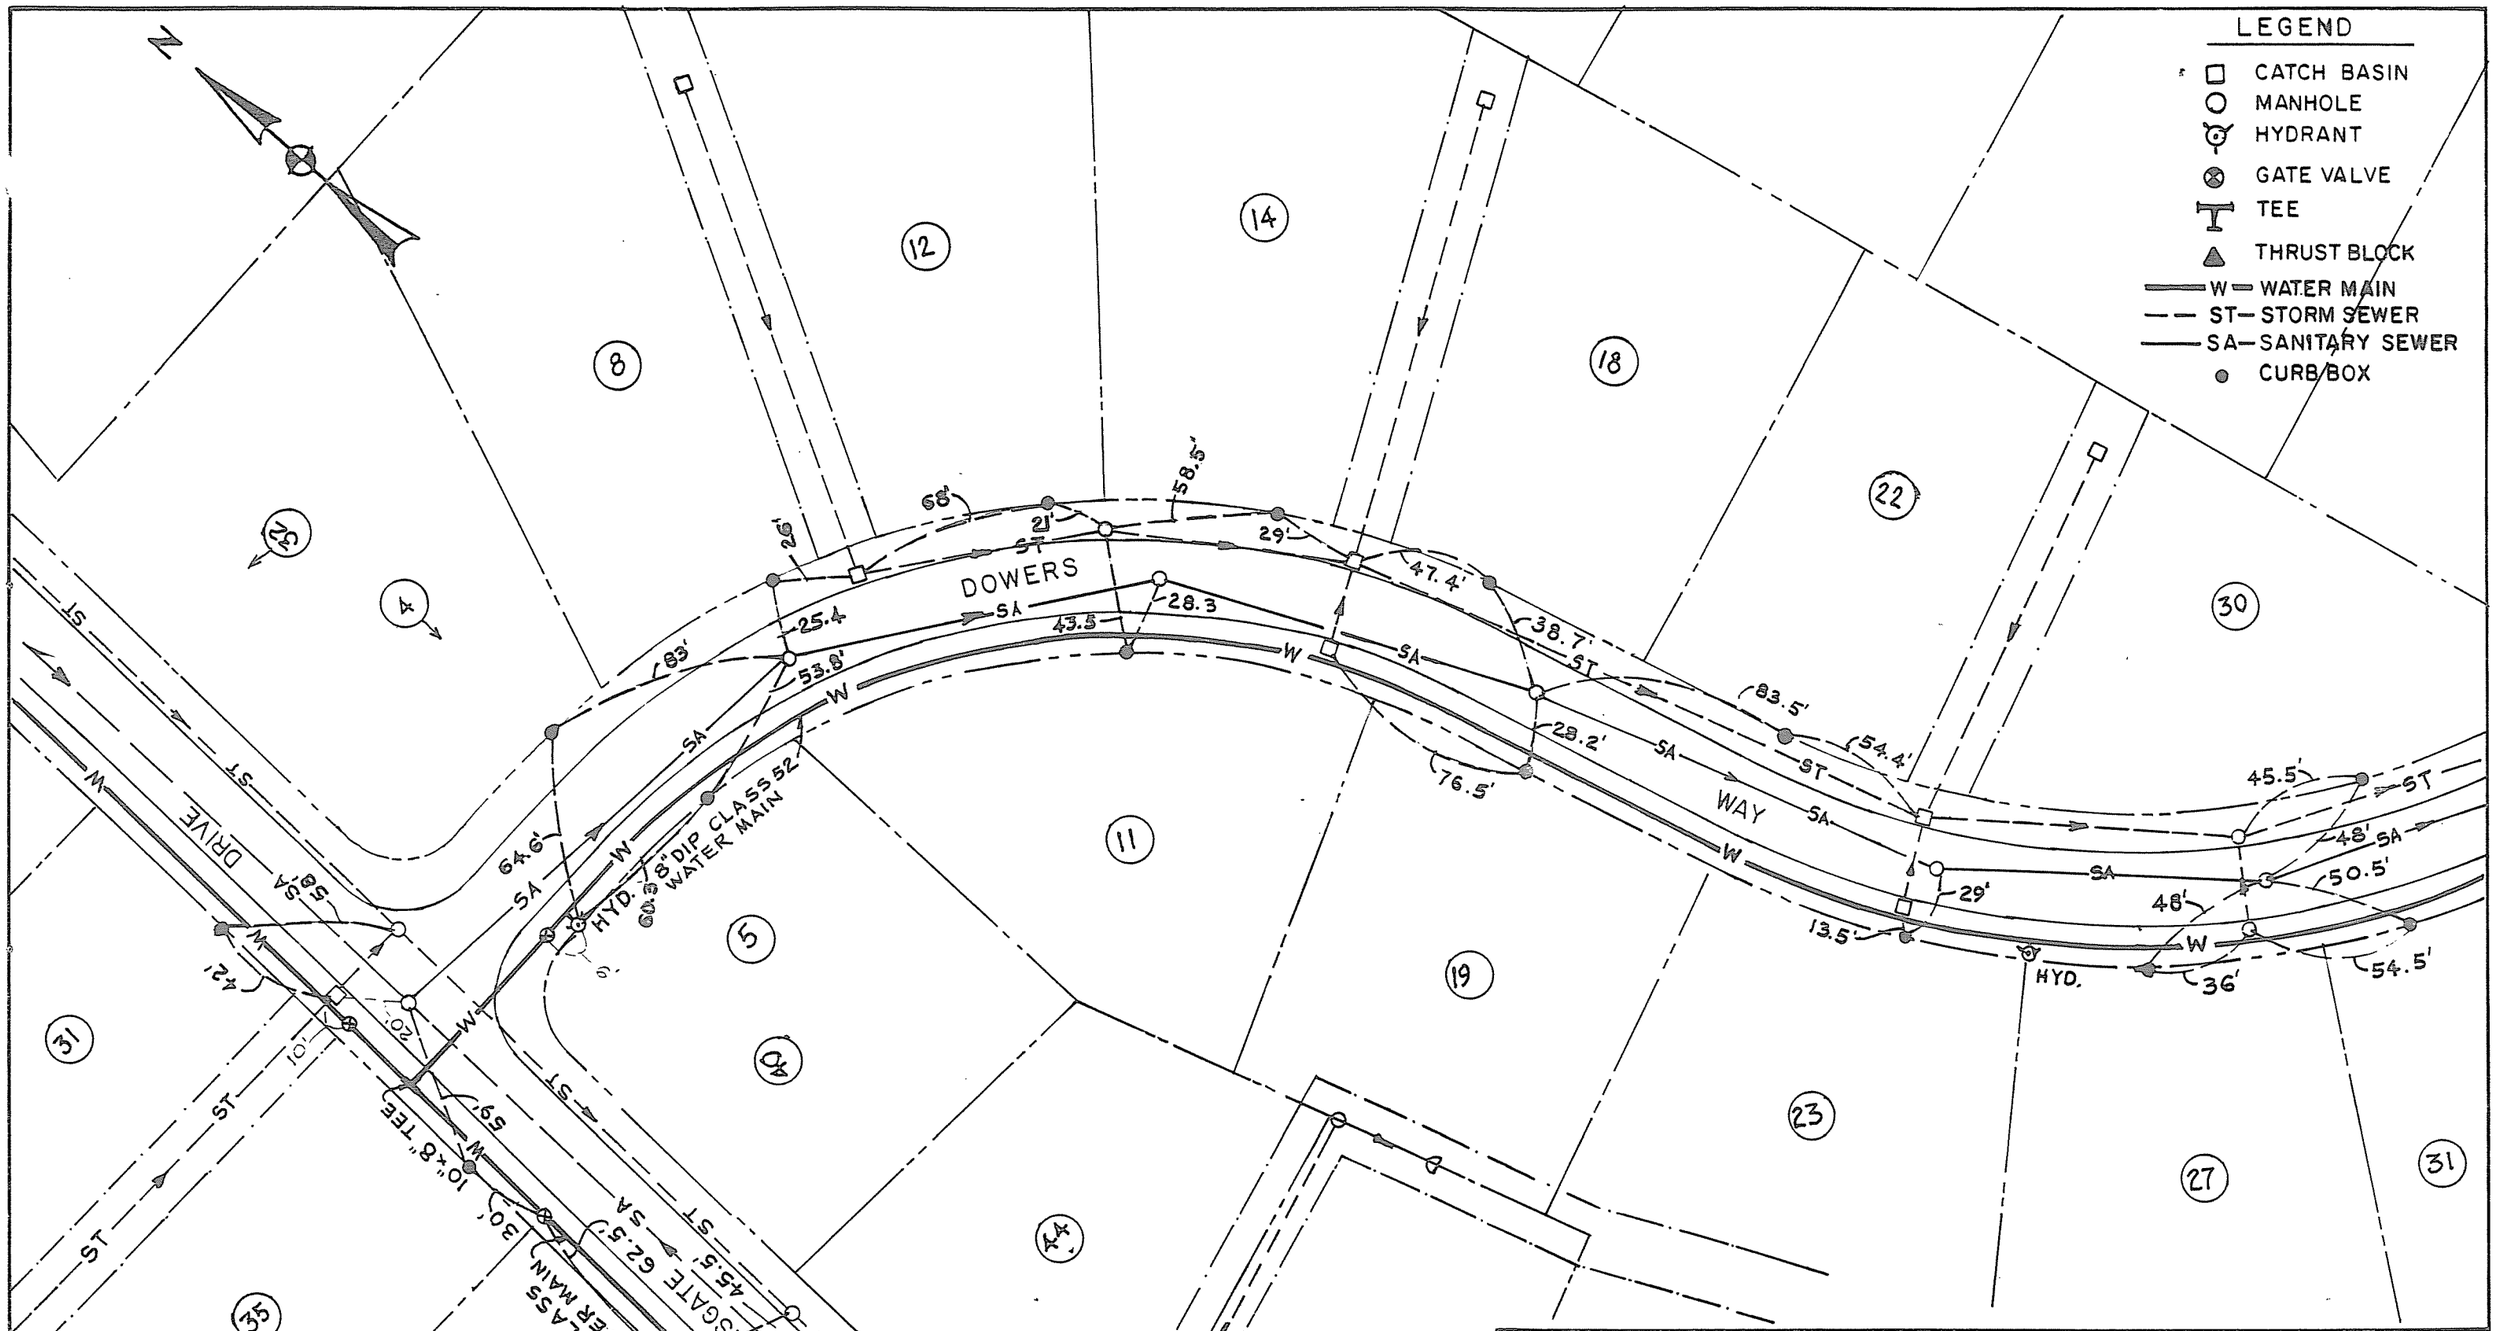

COUNTY ALBANY	DOWERS WAY HASWELL FARMS SUBDIVISION WATER MAIN LOCATIONS	STATE NEW YORK
DATE NOV.10, 1997		SCALE 1" = 50'
REVISION	*TOWN OF BETHLEHEM* *ENGINEERING DIVISION* 445 Delaware Ave. Delmar, New York 12054	DRAWING NO.

M.G.

577850