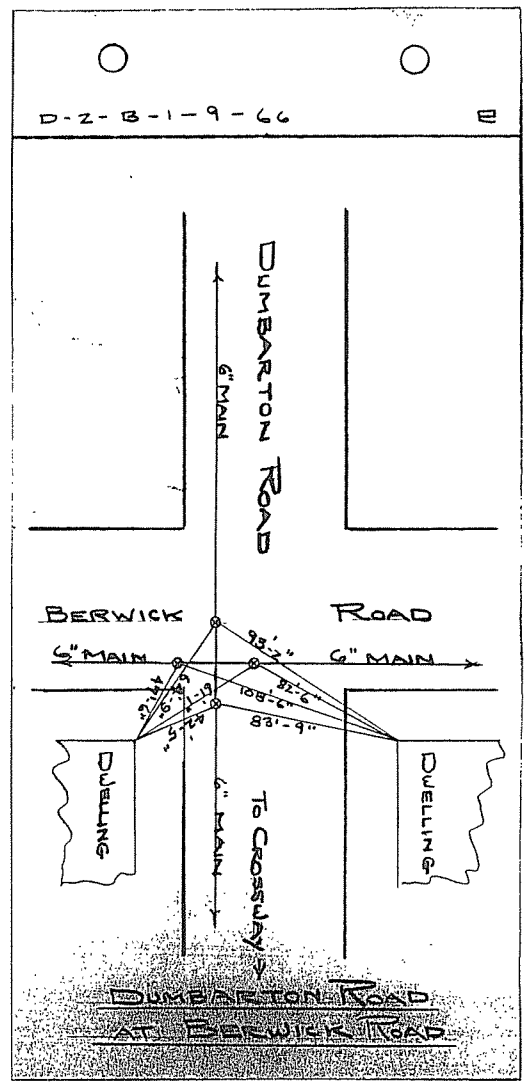

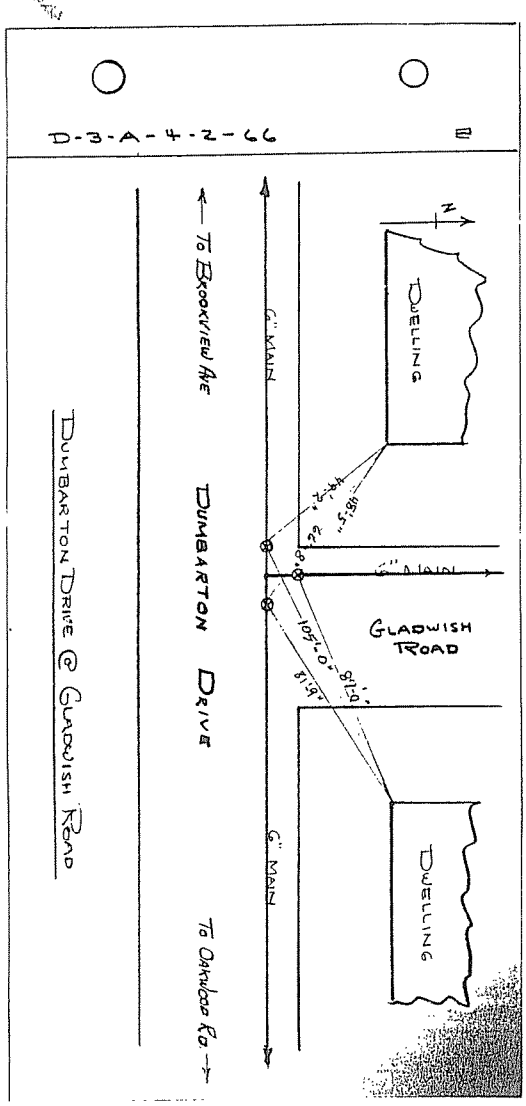

DUMBARTON ROAD

WATER MAIN