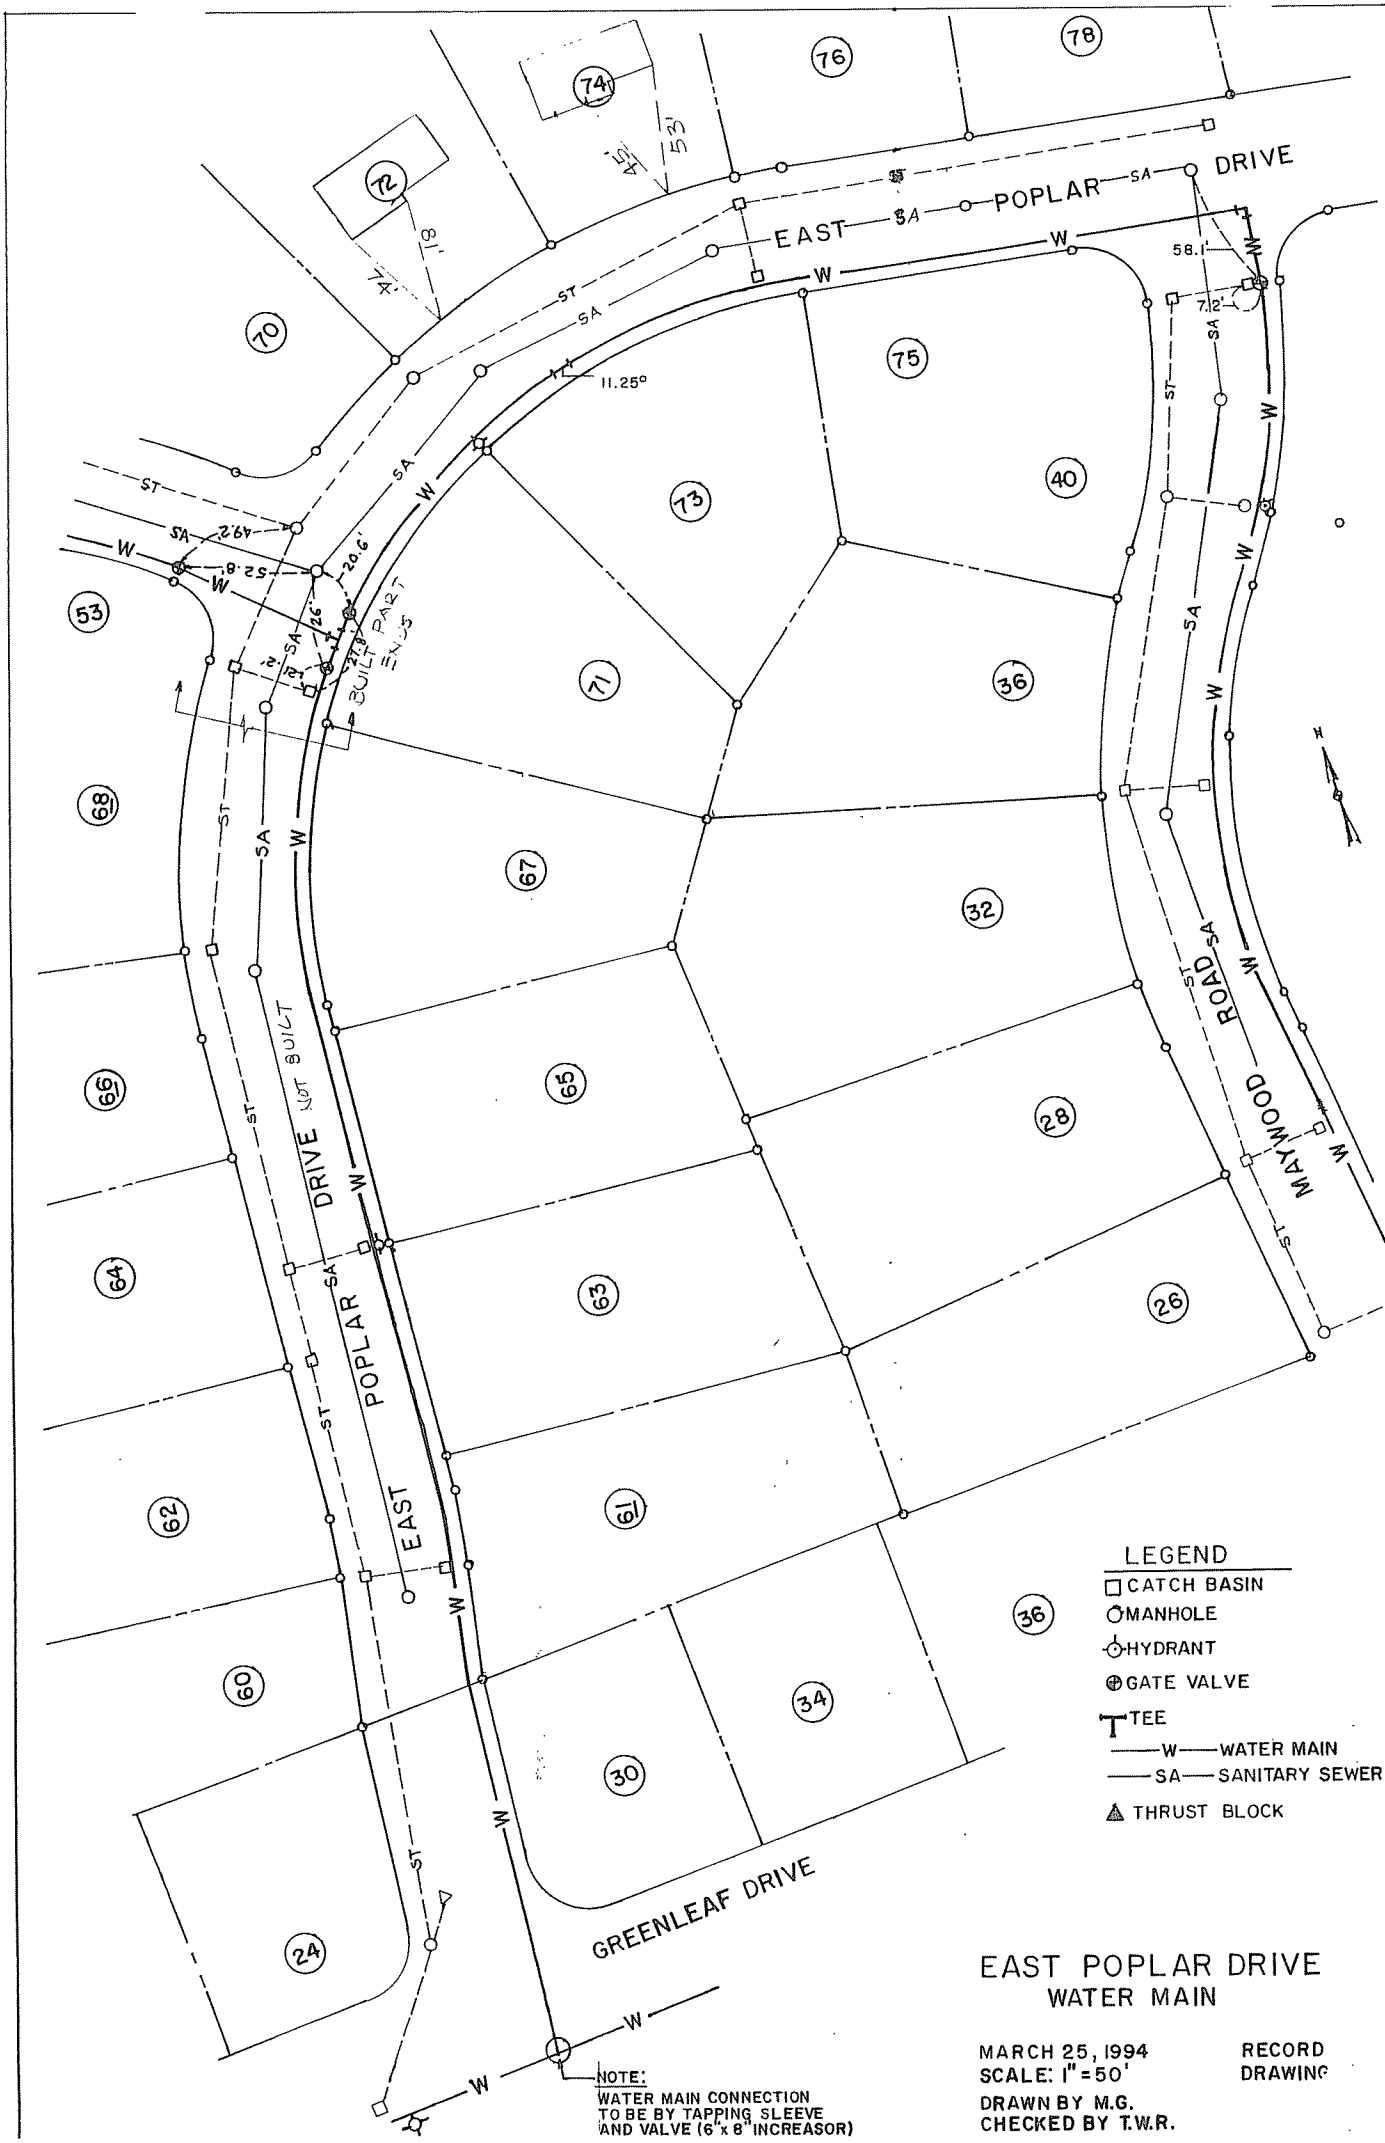
EAST POPLAR DRIVE
POPLAR DRIVE
EAST
MAYWOOD ROAD
GREENLEAF DRIVE
NOT BUILT
BUILT PART ENDS
11.25°
58.1'
7.12'
LEGEND
CATCH BASIN
MANHOLE
HYDRANT
GATE VALVE
TEE
W WATER MAIN
SA SANITARY SEWER
THRUST BLOCK
NOTE:
WATER MAIN CONNECTION TO BE BY TAPPING SLEEVE AND VALVE (6" x 8" INCREASOR)
EAST POPLAR DRIVE
WATER MAIN
MARCH 25, 1994
SCALE: 1" = 50'
DRAWN BY M.G.
CHECKED BY T.W.R.
RECORD DRAWING