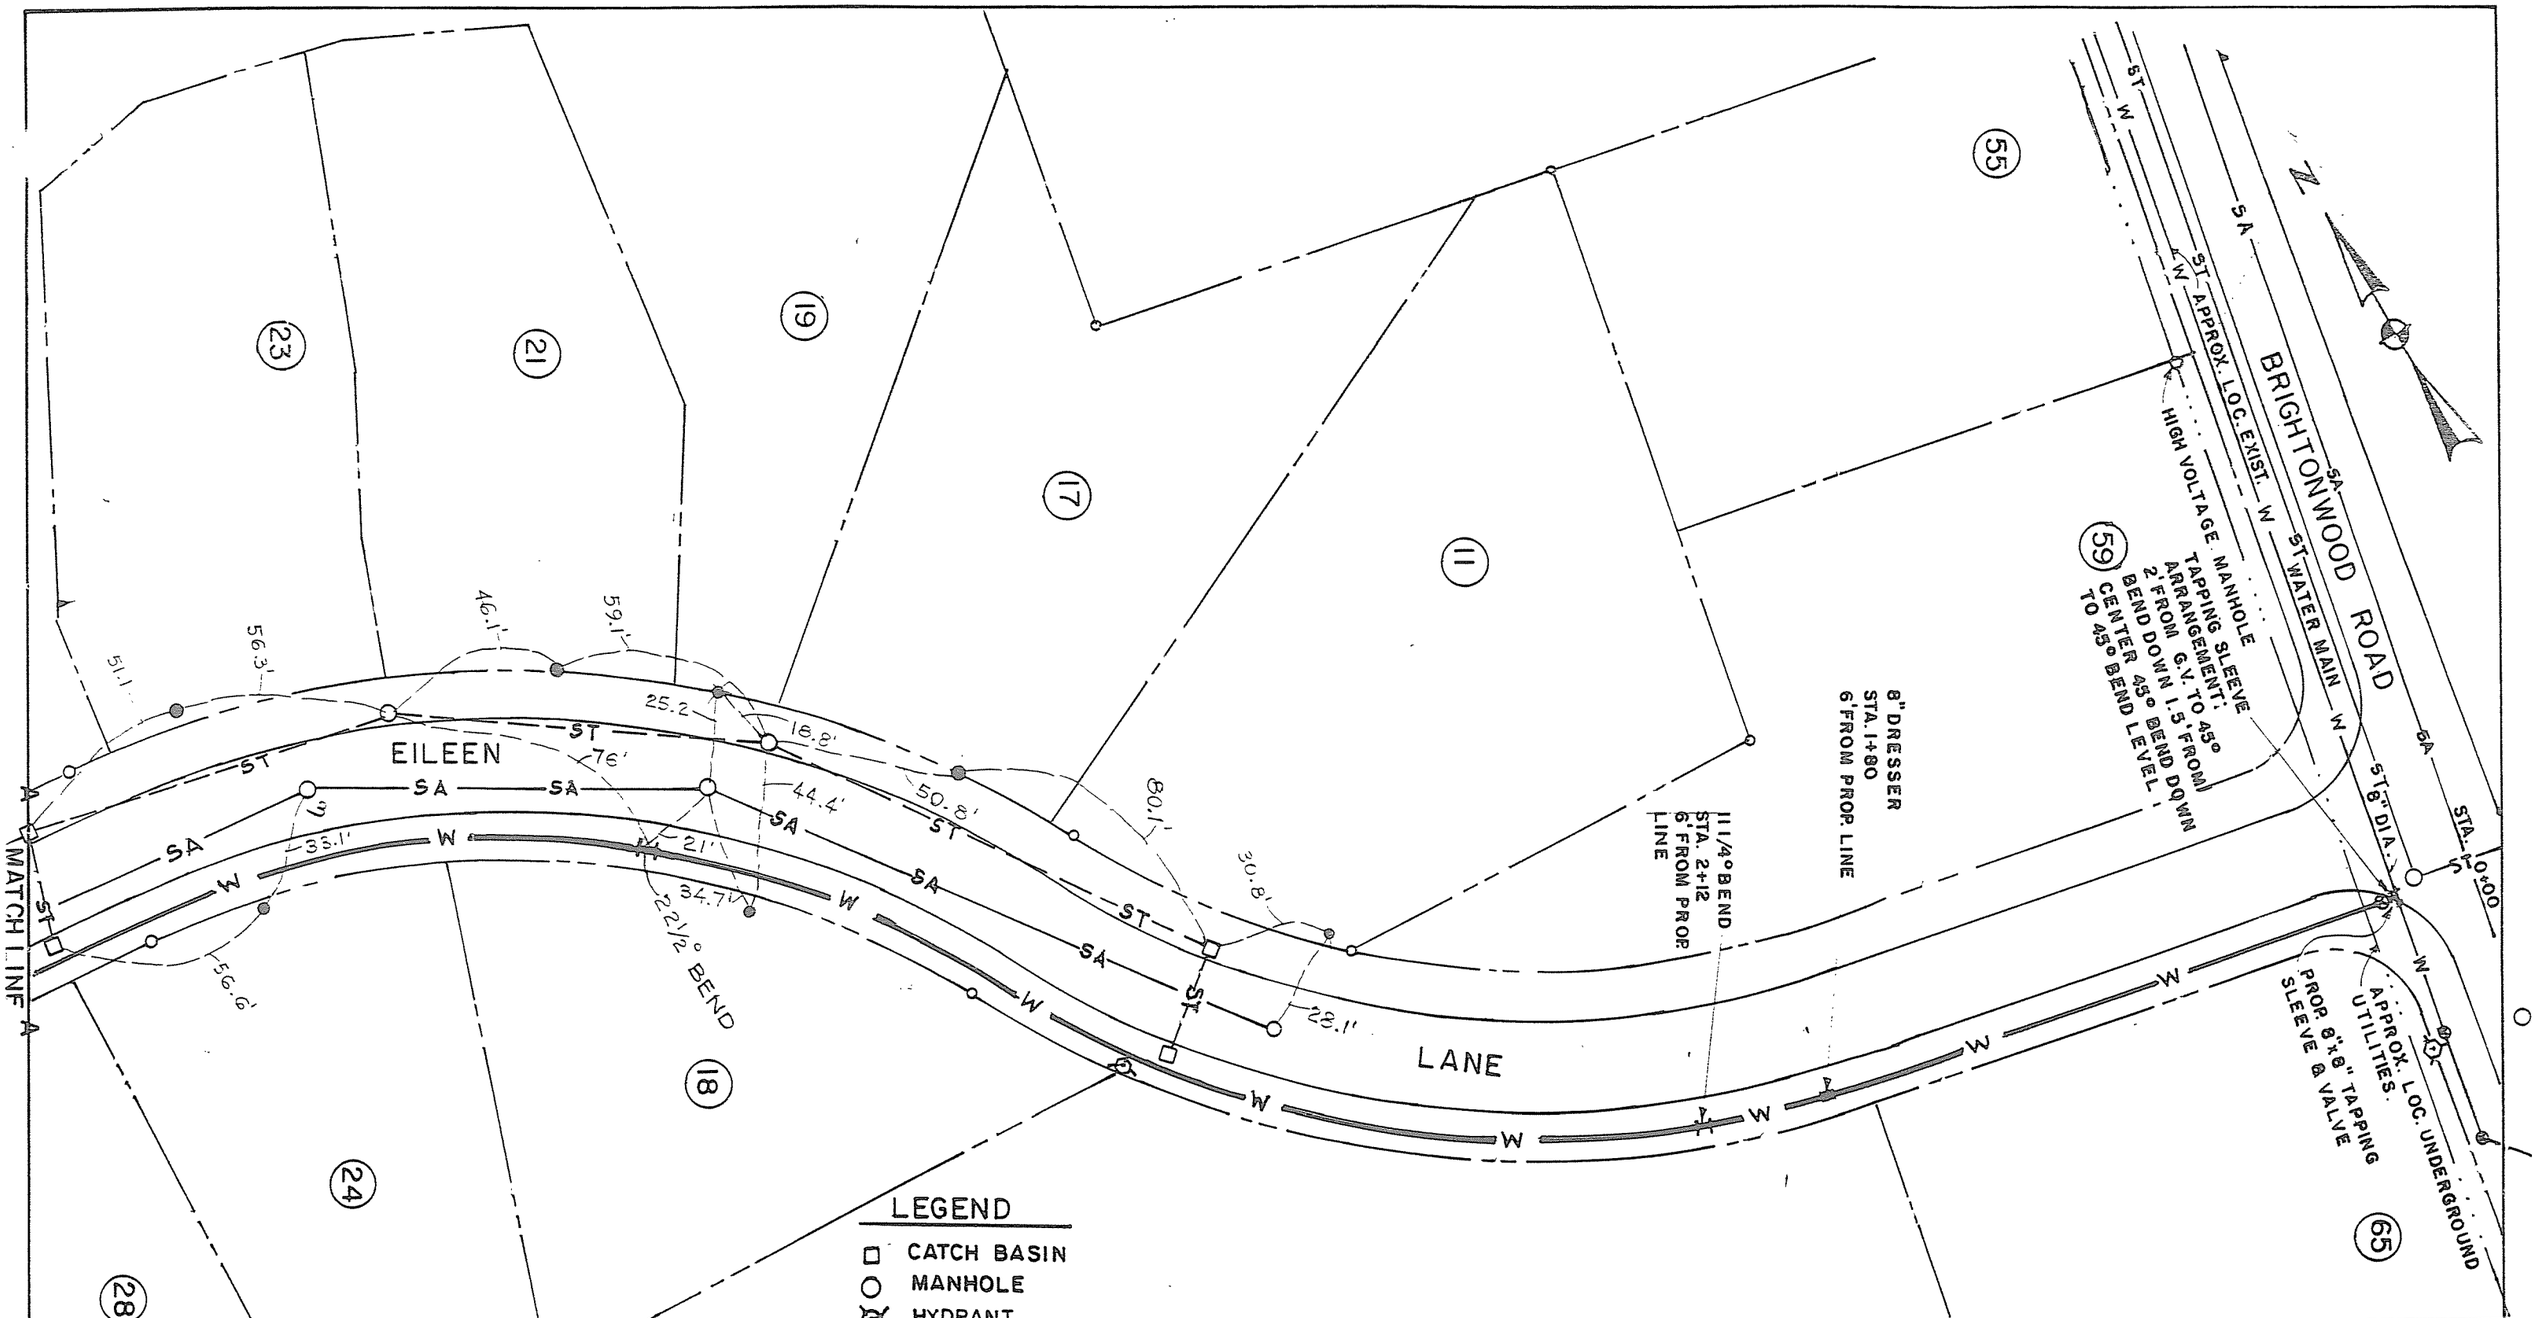


| | | |
|---|---|---|
| COUNTY ALBANY | EILEEN LANE<br>CLEARVIEW<br>WATER MAIN LOCATION | STATE NEW YORK |
| DATE APRIL 30, 1999 | | SCALE 1" = 40' |
| REVISION | TOWN OF BETHLEHEM<br>ENGINEERING DIVISION<br>445 Delaware Ave. Delmar, New York 12054 | DRAWING NO. 2 of 2 |

577650