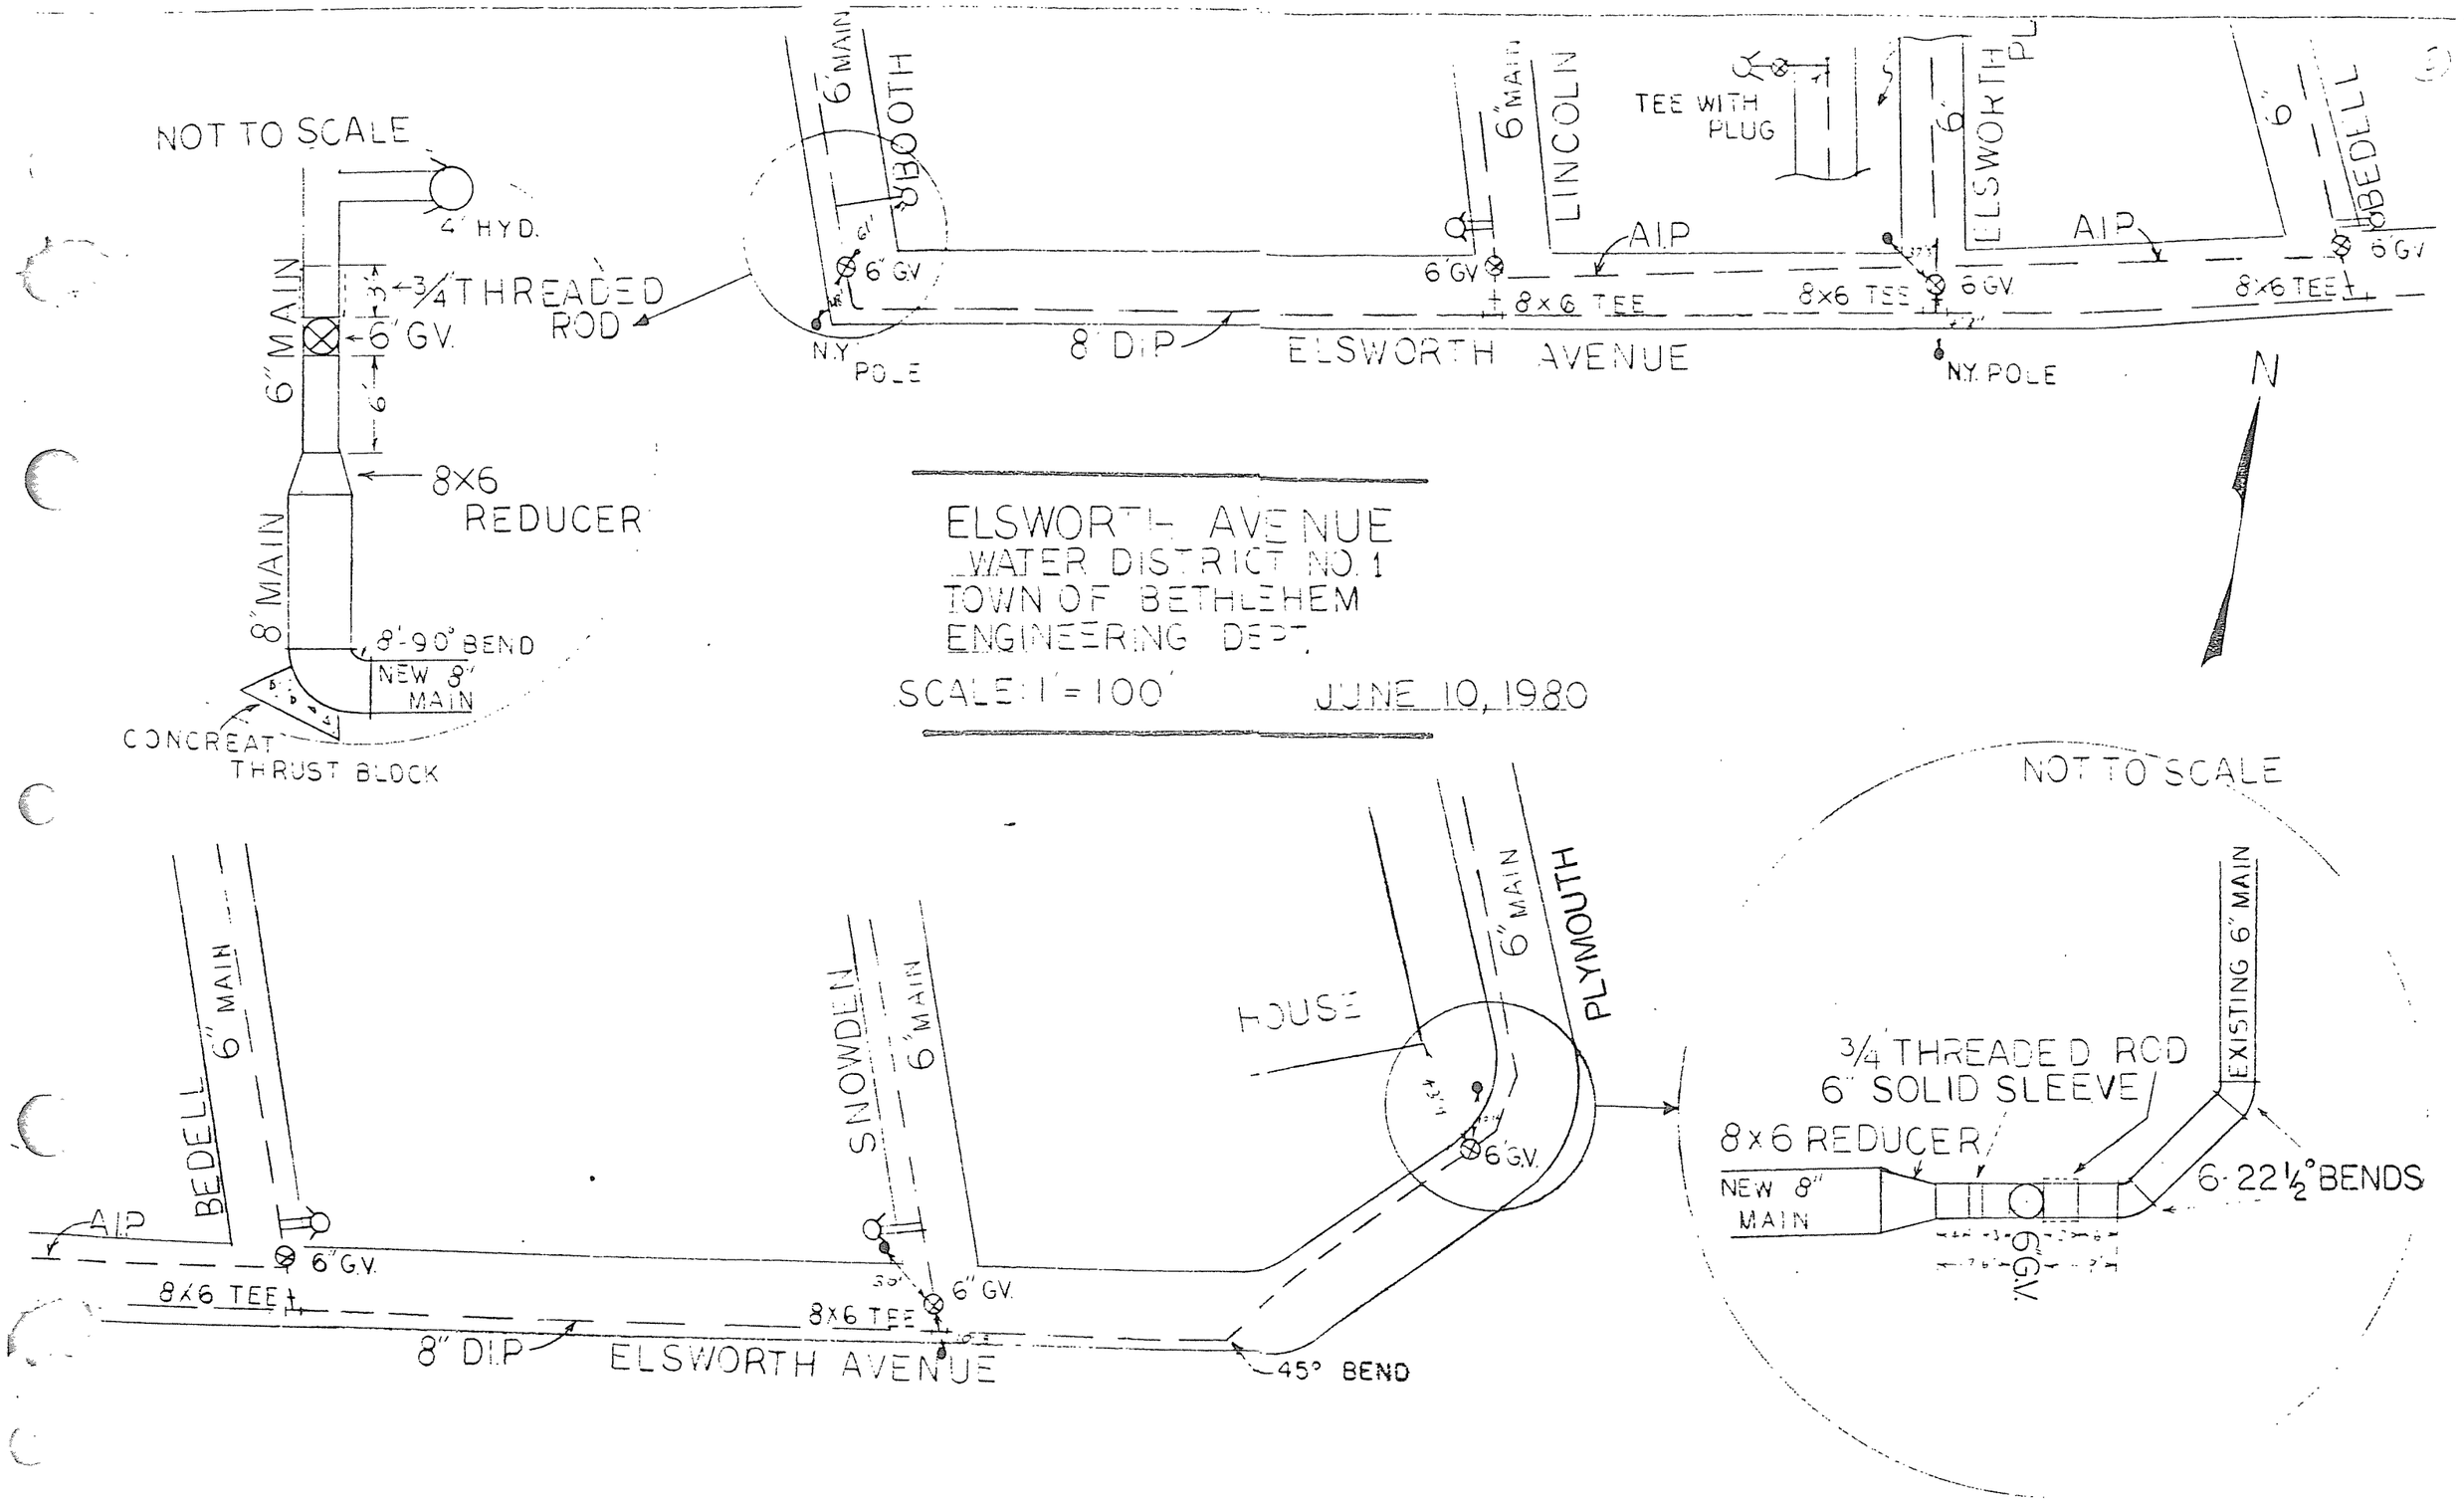
NOT TO SCALE
4" HYD.
6" MAIN
3/4 THREADED ROD
6" GV.
8×6 REDUCER
8" MAIN
8"-90° BEND
NEW 8" MAIN
CONCREAT THRUST BLOCK
6" MAIN
BOOTH
6" GV
N.Y. POLE
8" DIP
ELSWORTH AVENUE
6" MAIN
LINCOLN
TEE WITH PLUG
AIP
6" GV
8×6 TEE
ELSWORTH PL
N.Y. POLE
BEDELL
ELSWORTH AVENUE
WATER DISTRICT NO. 1
TOWN OF BETHLEHEM
ENGINEERING DEPT.
SCALE: 1" = 100'
JUNE 10, 1980
N
BEDELL
6" MAIN
AIP
6" G.V.
8×6 TEE
8" DIP
ELSWORTH AVENUE
SNOWDEN
6" MAIN
6" GV.
8×6 TEE
HOUSE
6" MAIN
PLYMOUTH
6" G.V.
45° BEND
NOT TO SCALE
EXISTING 6" MAIN
3/4 THREADED ROD
6" SOLID SLEEVE
8×6 REDUCER
NEW 8" MAIN
6-22½° BENDS
6" G.V.