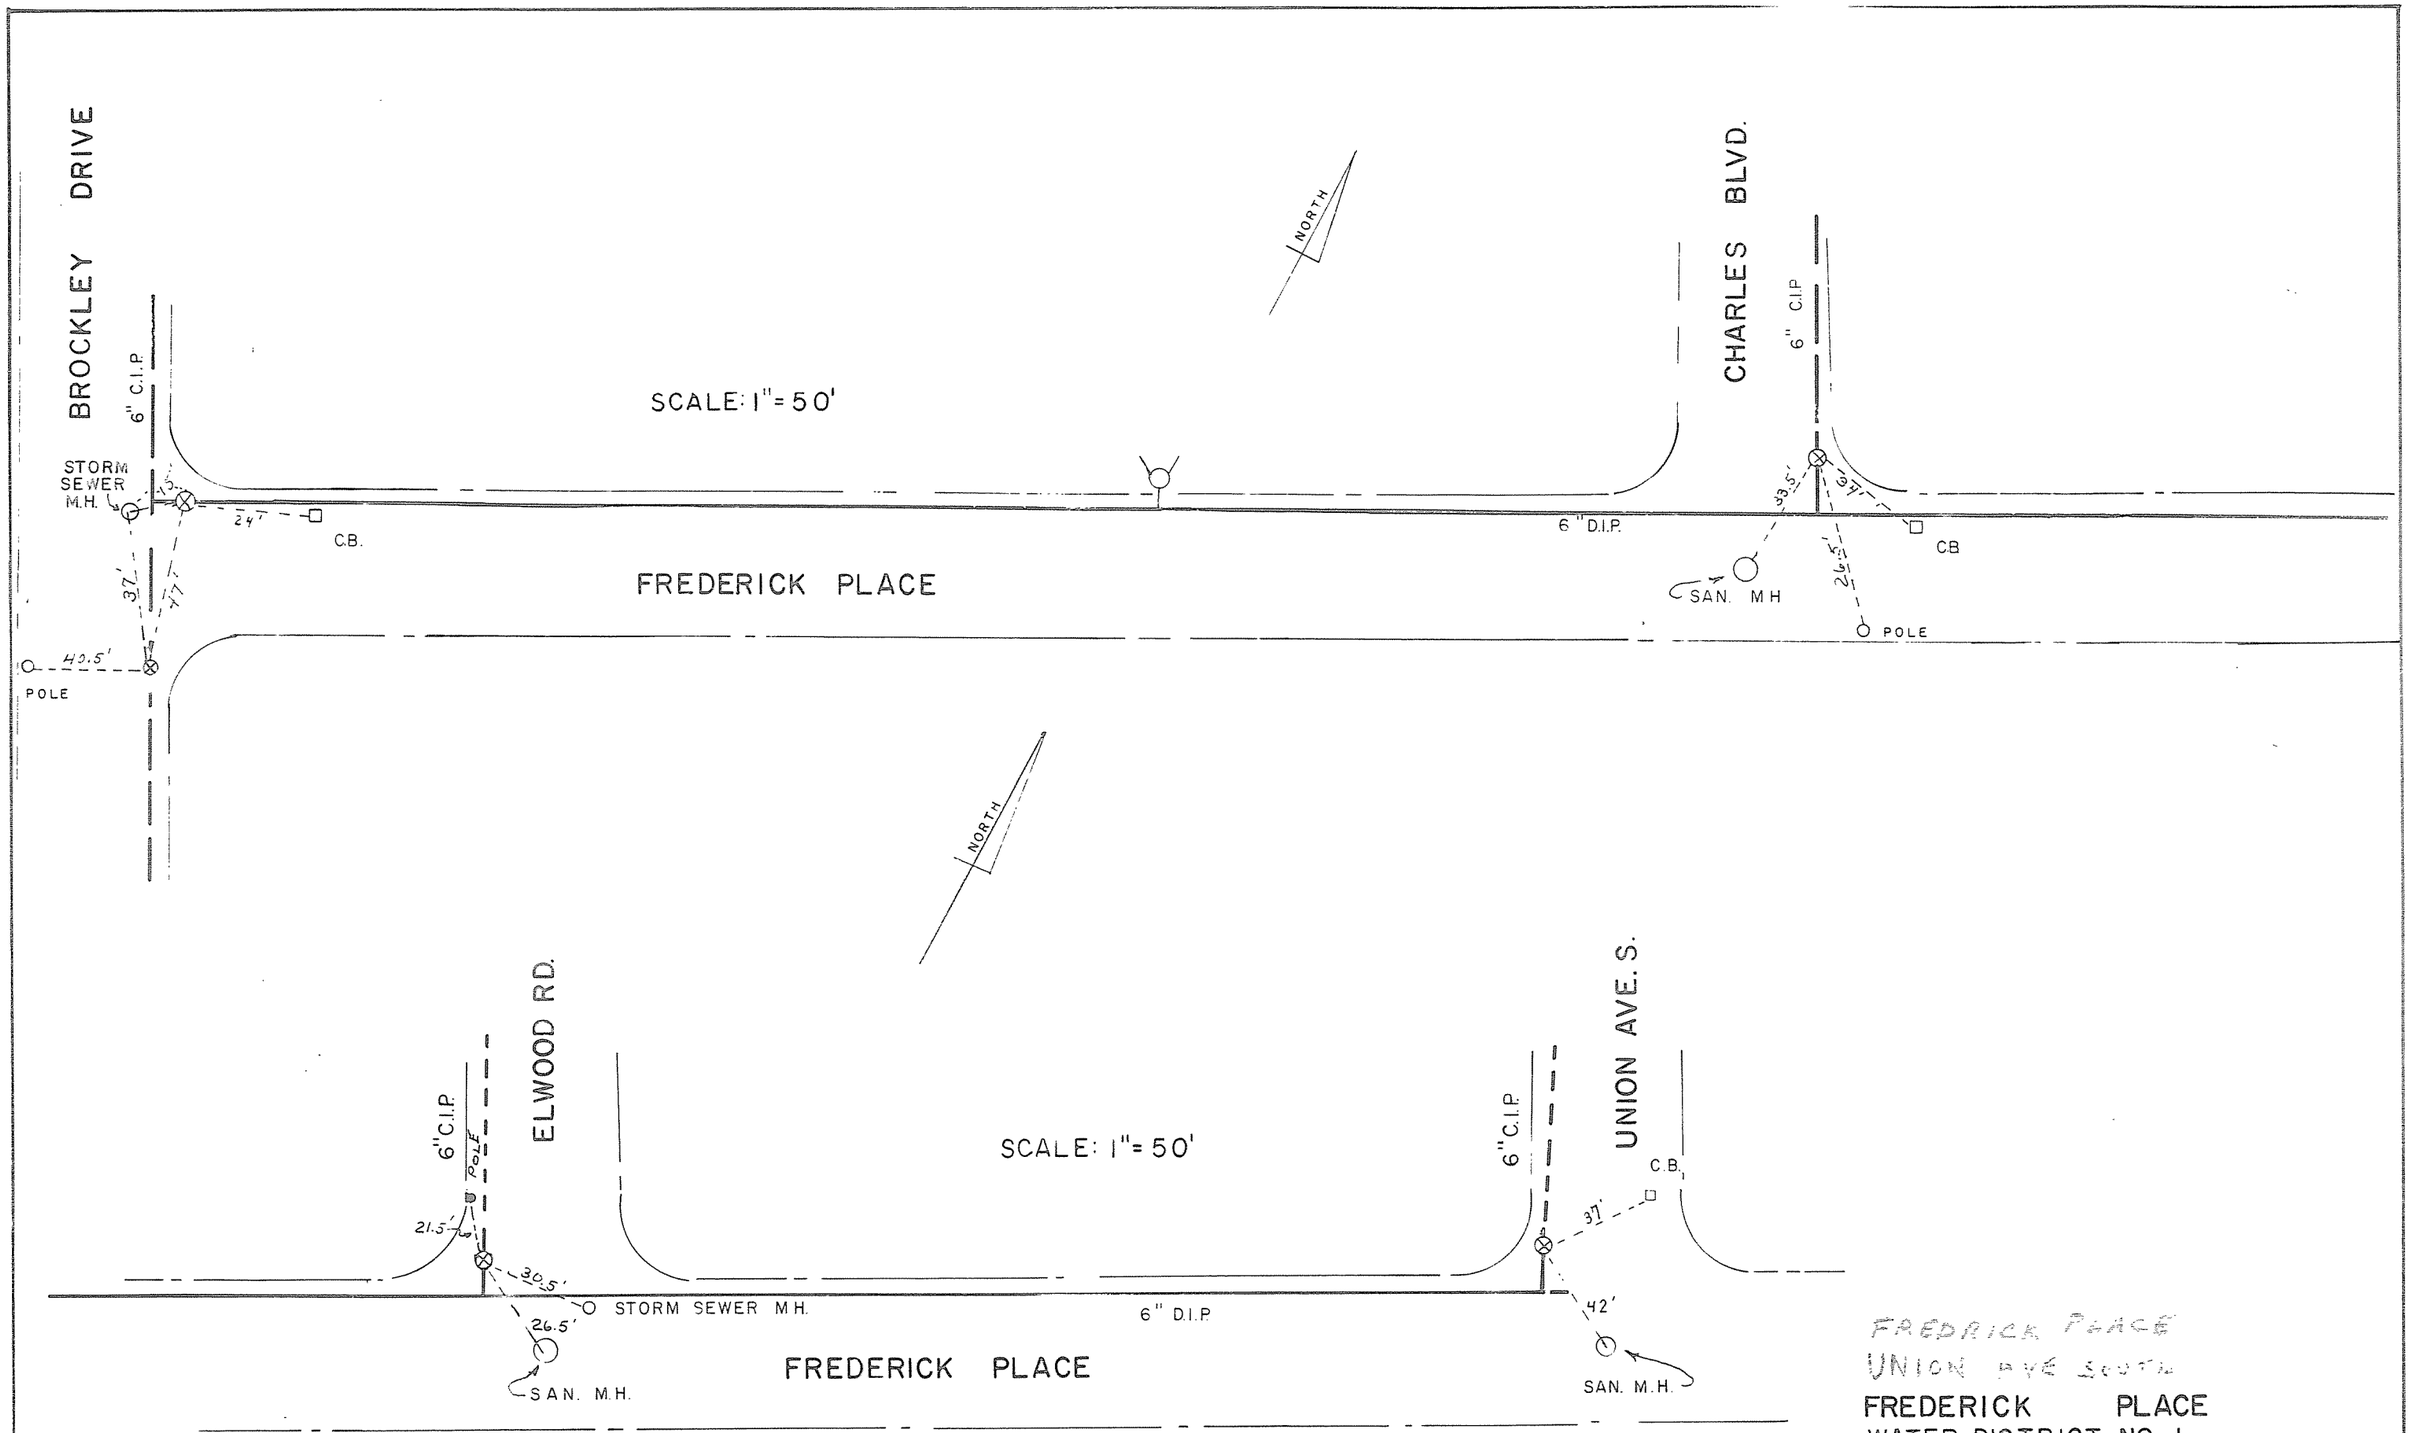

⊗ DENOTES LINE VALVE

NOTE: TIE DISTANCES SHOWN ON THIS SHEET ARE NOT TO SCALE.

FREDRICK PLACE
UNION AVE SOUTH

FREDERICK PLACE
WATER DISTRICT NO. 1
TOWN OF BETHLEHEM

RECORD OF INSTALLATIONS

J. KENNETH FRASER & ASSOCIATES, P.C.
CONSULTING ENGRS. RENSSELAER, N.Y.