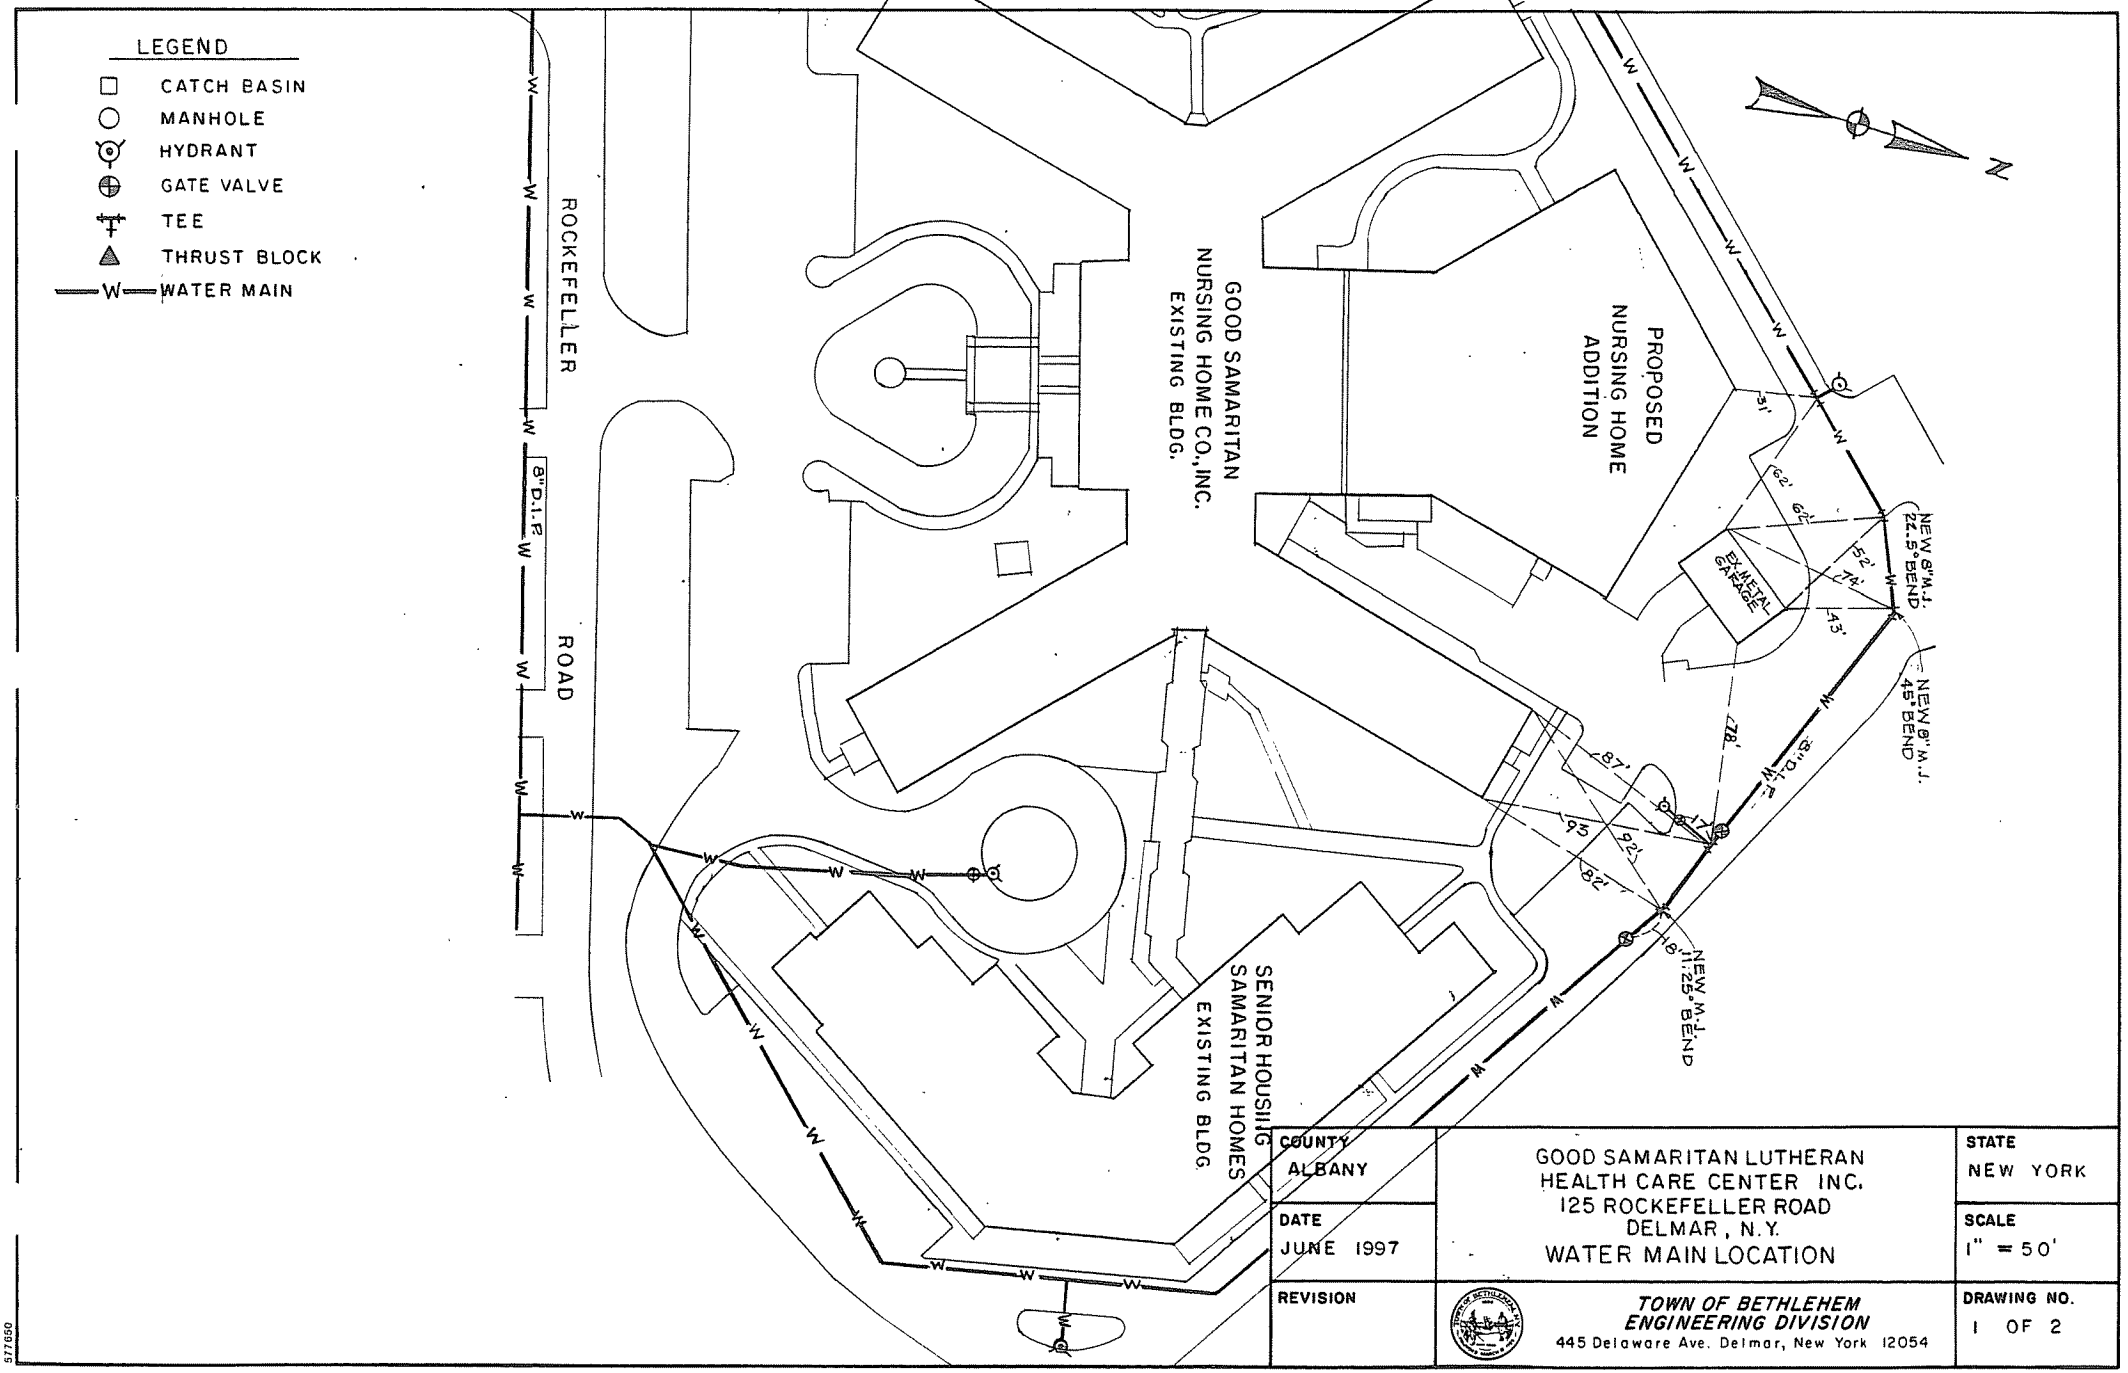
LEGEND
CATCH BASIN
MANHOLE
HYDRANT
GATE VALVE
TEE
THRUST BLOCK
WATER MAIN
ROCKEFELLER ROAD
8" D.I.P.
GOOD SAMARITAN NURSING HOME CO., INC. EXISTING BLDG.
PROPOSED NURSING HOME ADDITION
EX. METAL GARAGE
SENIOR HOUSING SAMARITAN HOMES EXISTING BLDG.
NEW 8" M.J. 22.5° BEND
NEW 8" M.J. 45° BEND
NEW M.J. 11.25° BEND
8" D.I.P.
N
COUNTY ALBANY
DATE JUNE 1997
REVISION
GOOD SAMARITAN LUTHERAN HEALTH CARE CENTER INC.
125 ROCKEFELLER ROAD
DELMAR, N.Y.
WATER MAIN LOCATION
TOWN OF BETHLEHEM
ENGINEERING DIVISION
445 Delaware Ave. Delmar, New York 12054
STATE NEW YORK
SCALE 1" = 50'
DRAWING NO. 1 OF 2

577650