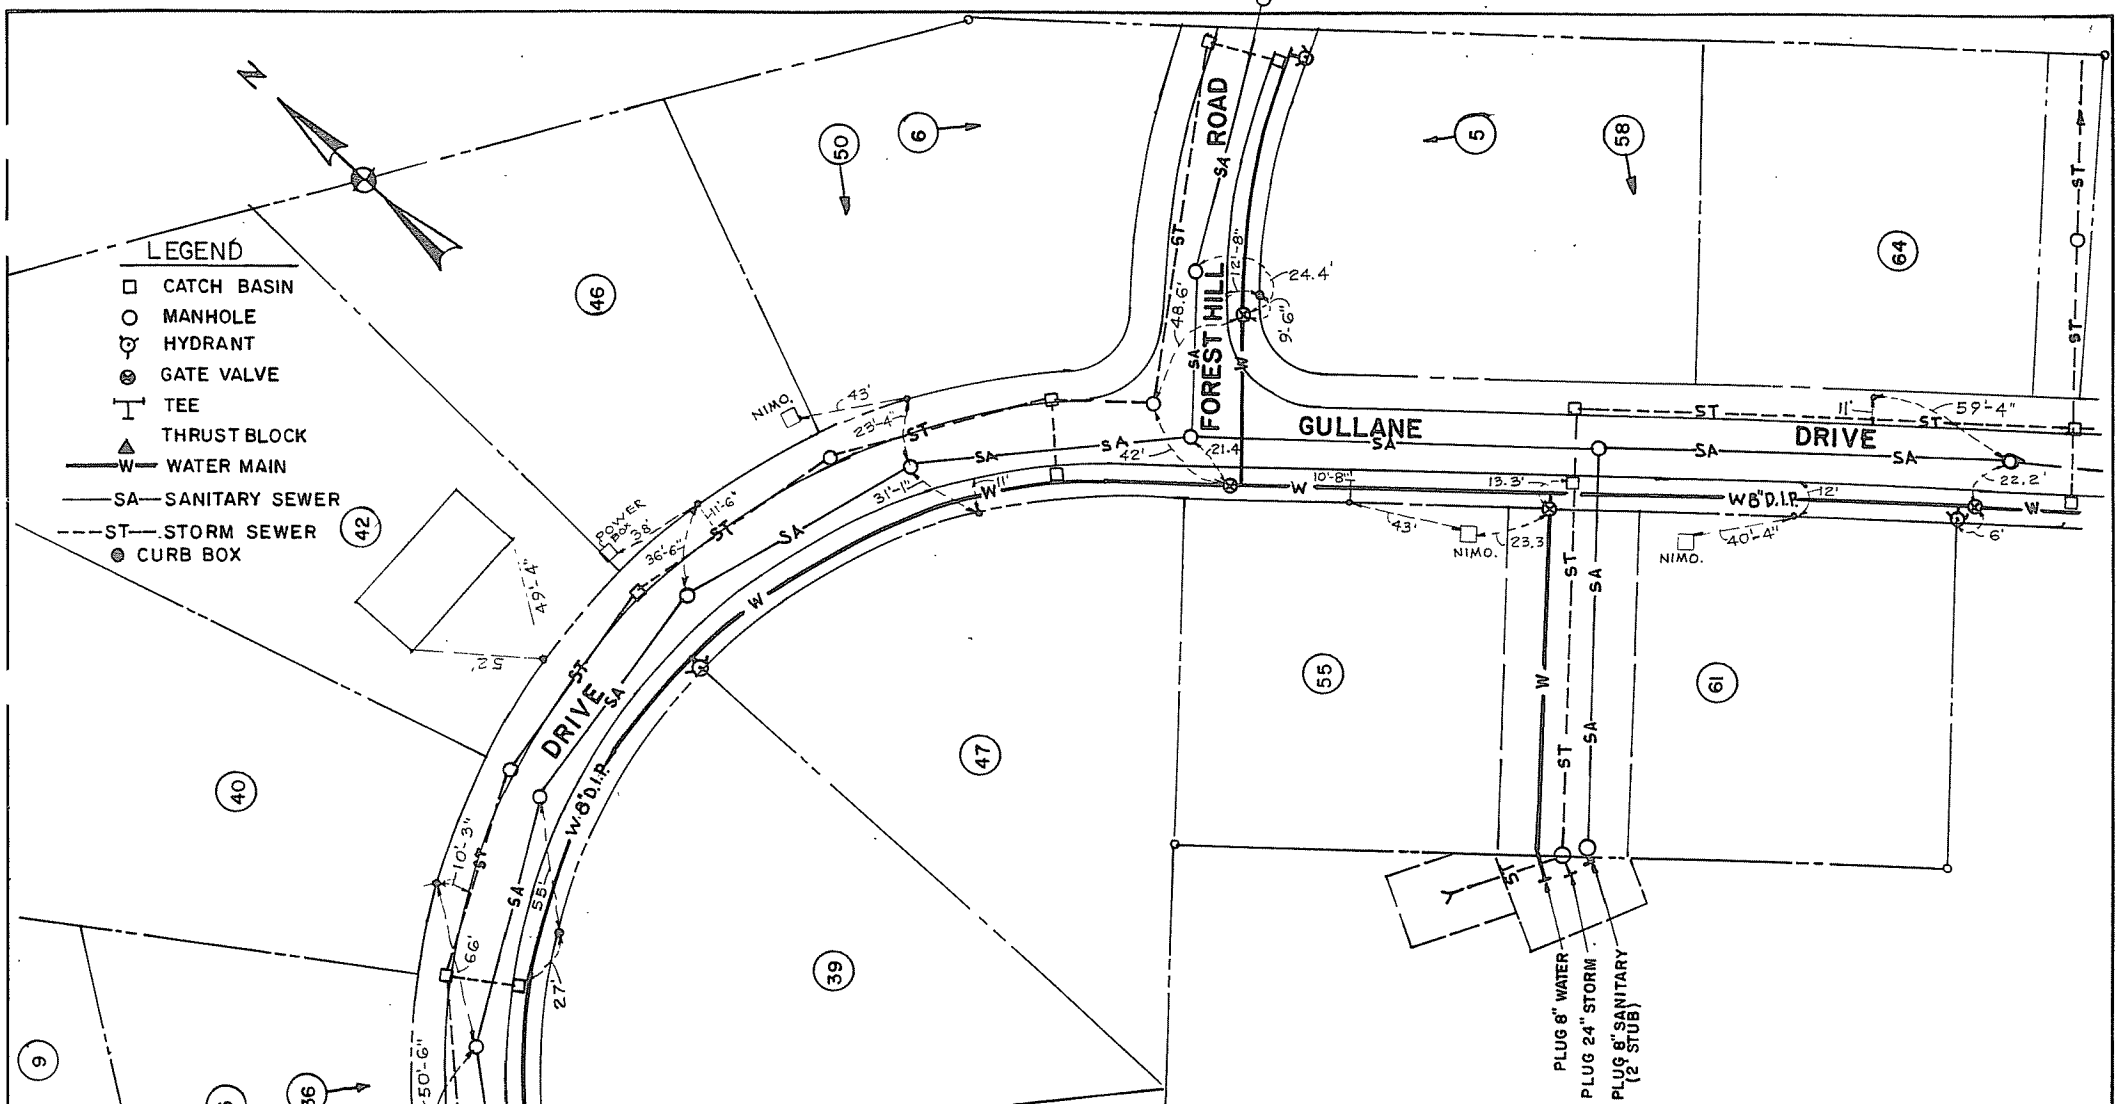

NOTE:
ALL WATER MAINS SHALL BE 8" DUCTILE IRON

COUNTY ALBANY	GULLANE DRIVE CEDAR RIDGE PHASE 3 WATER MAIN	STATE NEW YORK
DATE NOV. 27, 1996		SCALE 1" = 50'
REVISION	TOWN OF BETHLEHEM ENGINEERING DIVISION 445 Delaware Ave. Delmar, New York 12054	DRAWING NO.

CEDAR RIDGE SEC. 3

577650