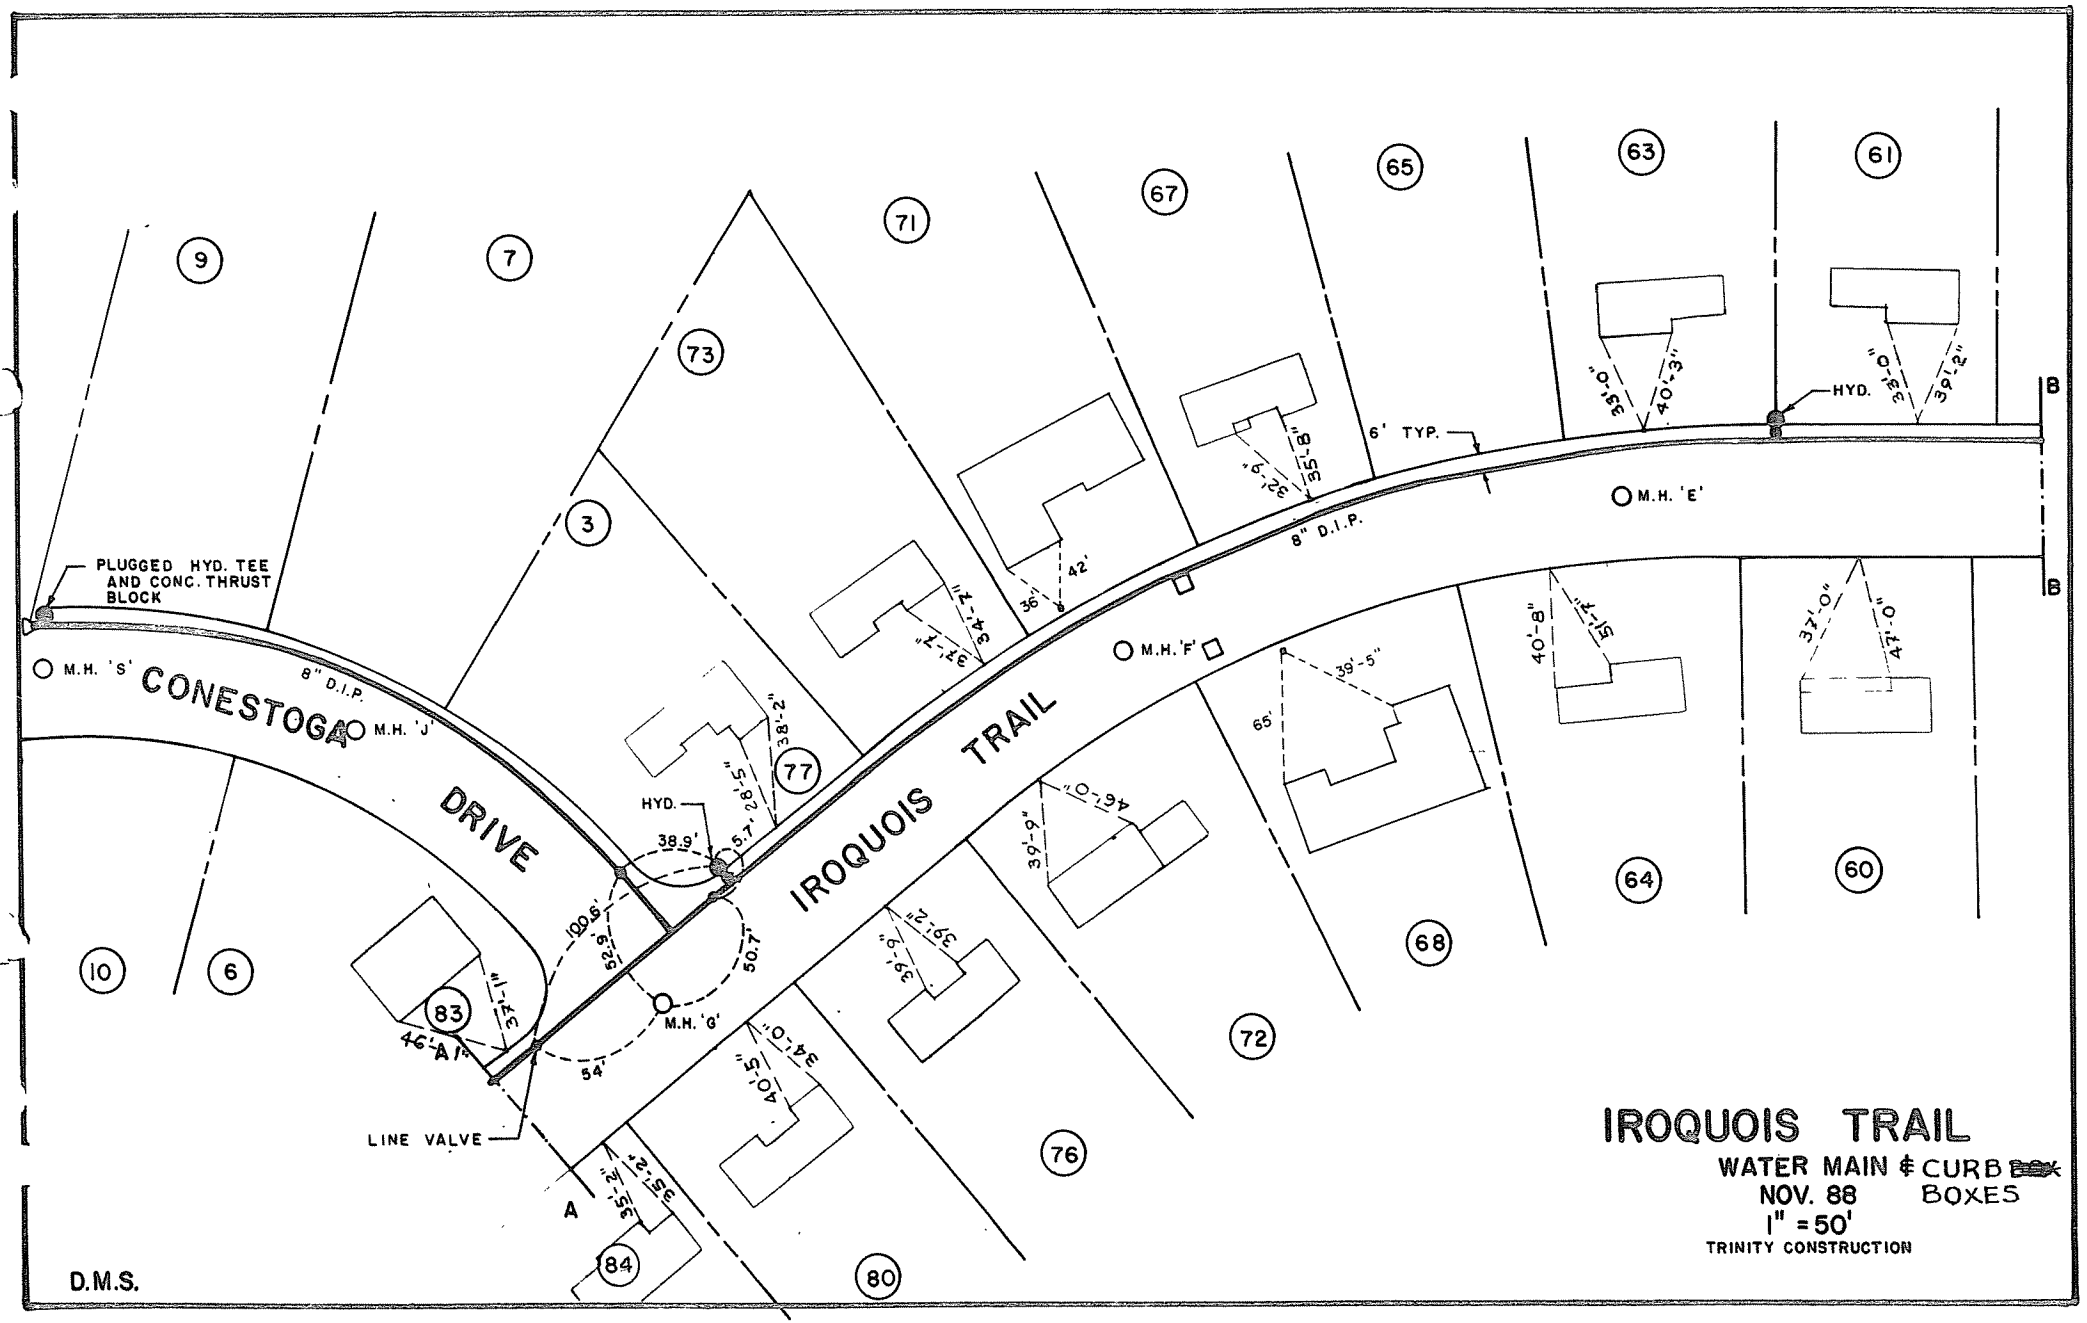
IROQUOIS TRAIL
WATER MAIN & CURB BOXES
NOV. 88
1" = 50'
TRINITY CONSTRUCTION
CONESTOGA DRIVE
IROQUOIS TRAIL
PLUGGED HYD. TEE AND CONC. THRUST BLOCK
M.H. 'S'
M.H. 'J'
M.H. 'G'
M.H. 'F'
M.H. 'E'
8" D.I.P.
6' TYP.
HYD.
LINE VALVE
A
B
D.M.S.