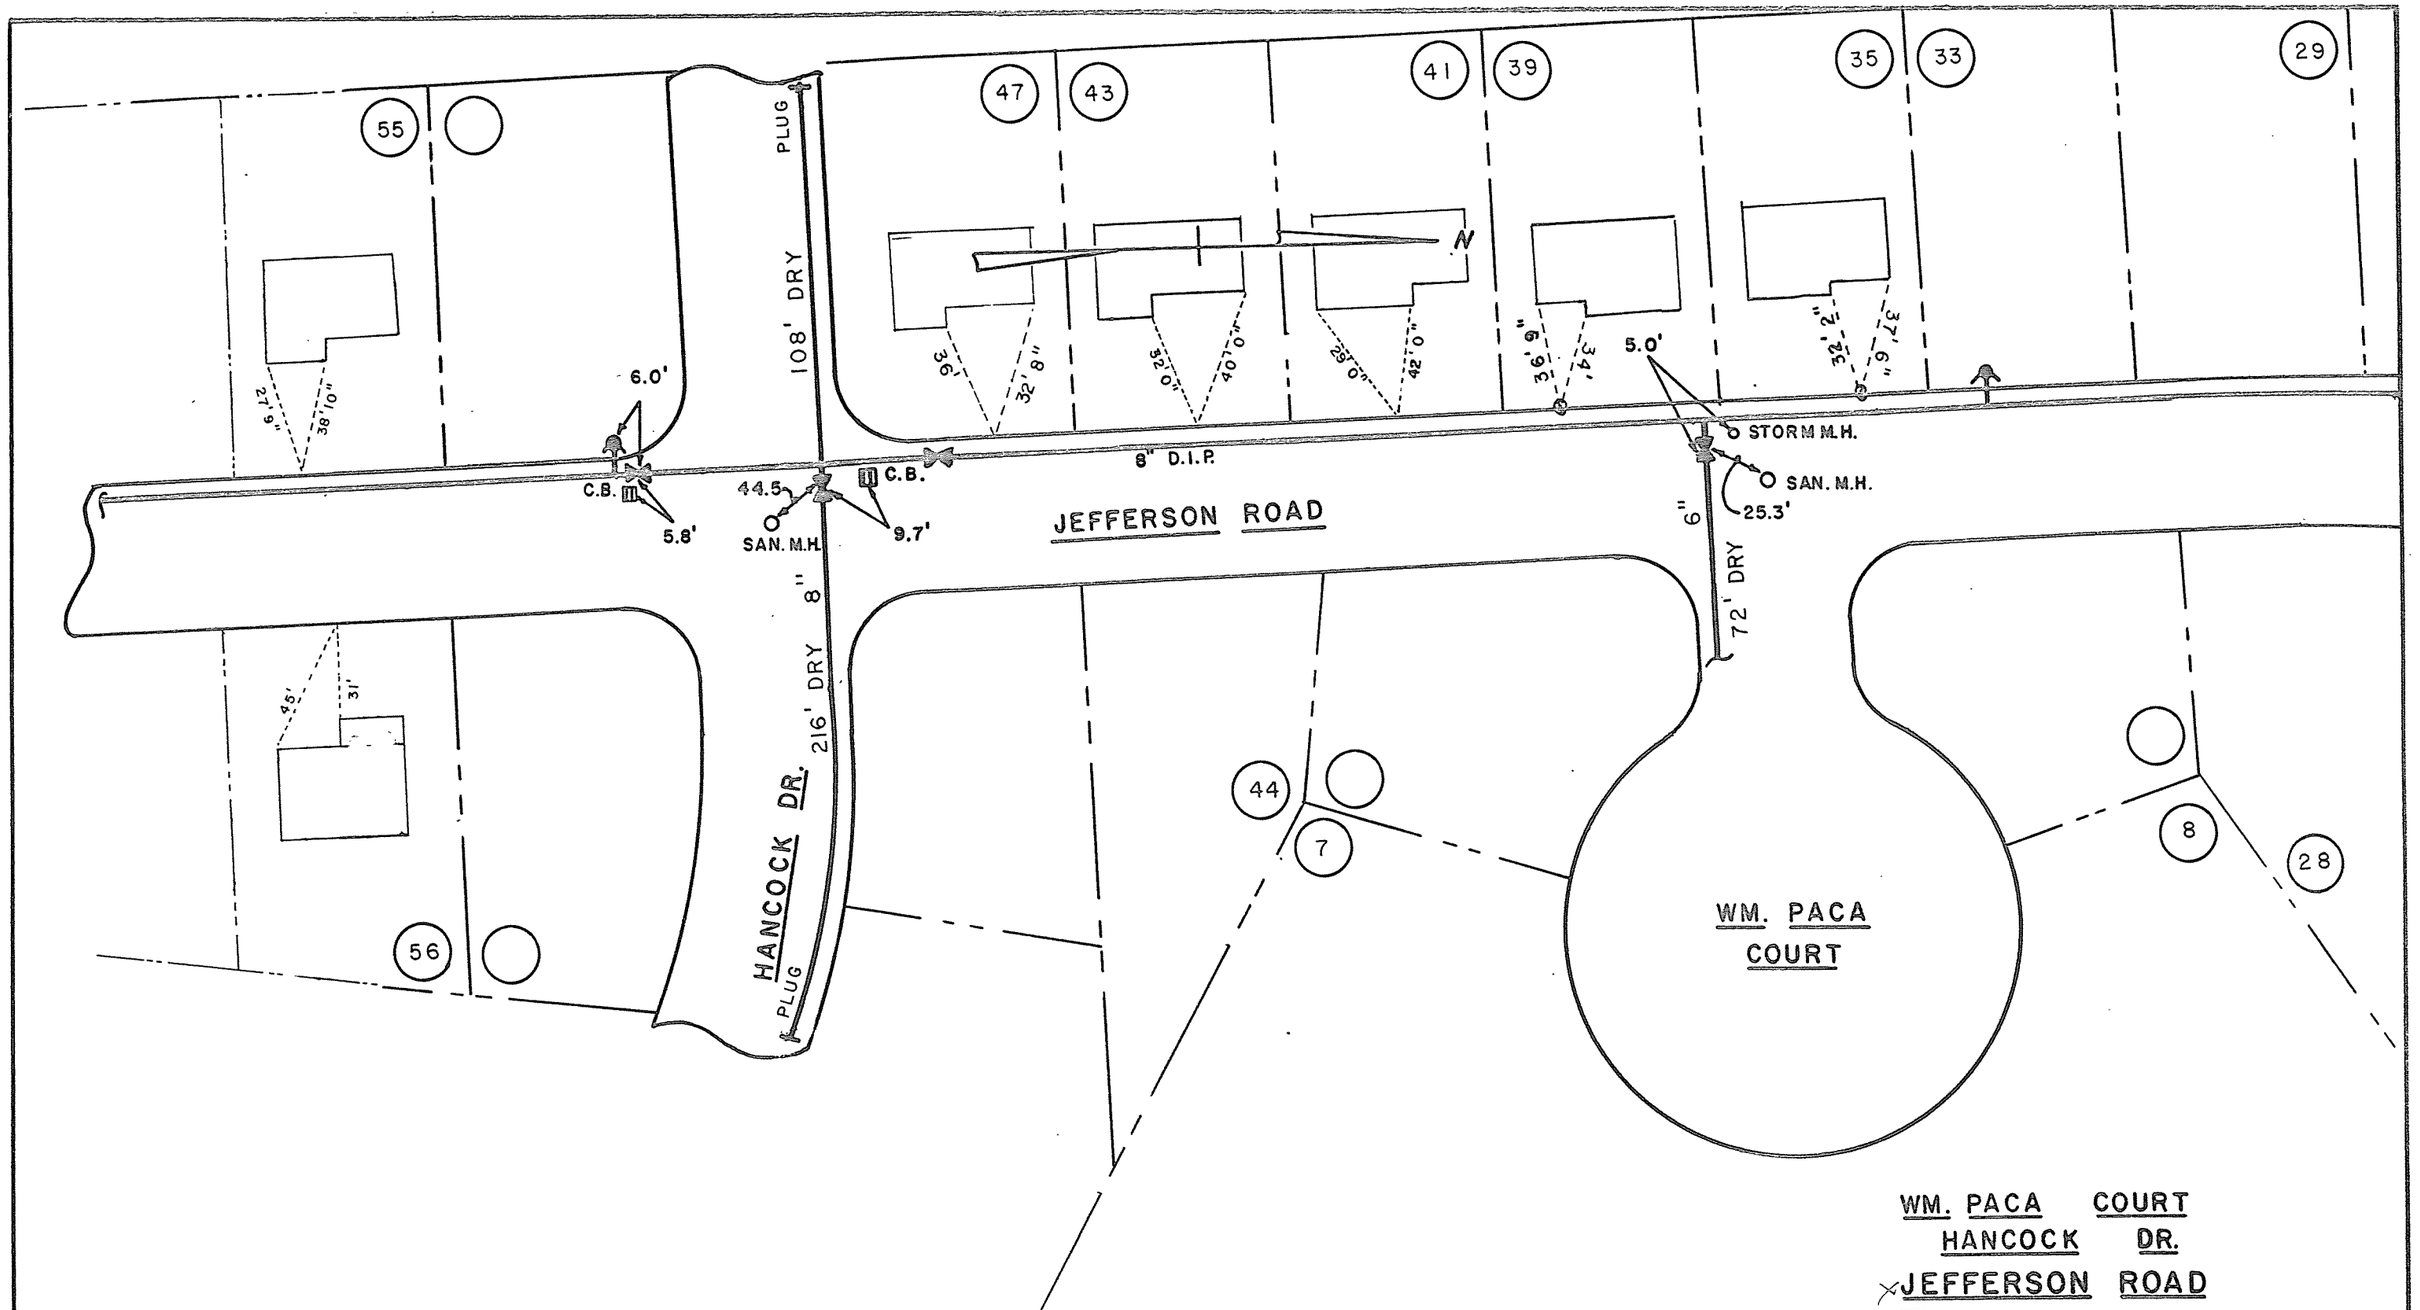

WM. PACA COURT
HANCOCK DR.
JEFFERSON ROAD
"BICENTENNIAL WOODS"

WATER DISTRICT NO. 1
TOWN OF BETHLEHEM

RECORD OF INSTALLATIONS

J. KENNETH FRASER & ASSOCIATES, P.C.
CONSULTING ENGINEERS, RENSSELAER, N.Y.

DWN. BY H.P.J.
CHK BY W.T.B.
SCALE 1"=50'
OCTOBER 1980