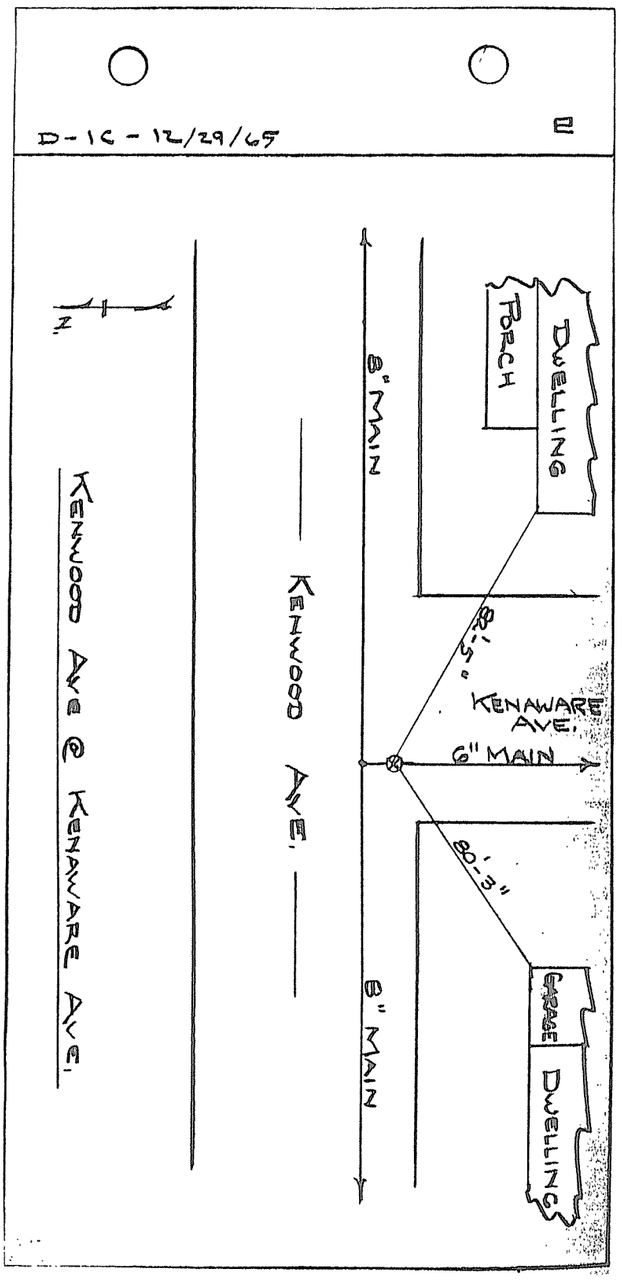

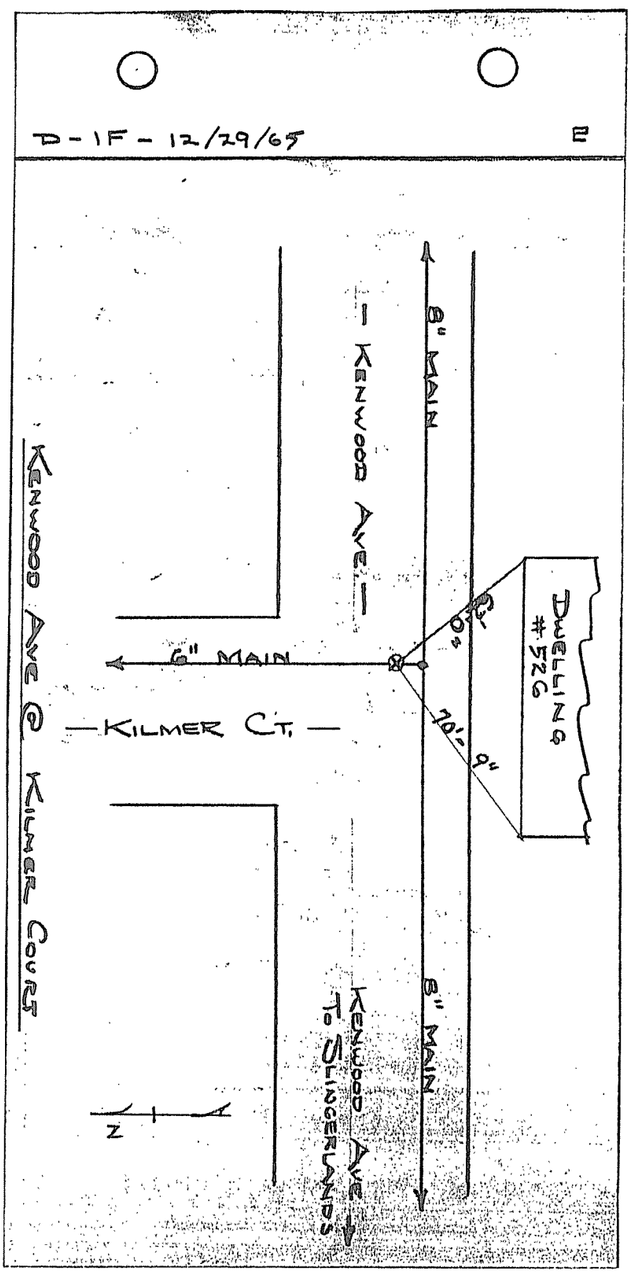

KENWOOD AVENUE

WATER MAIN