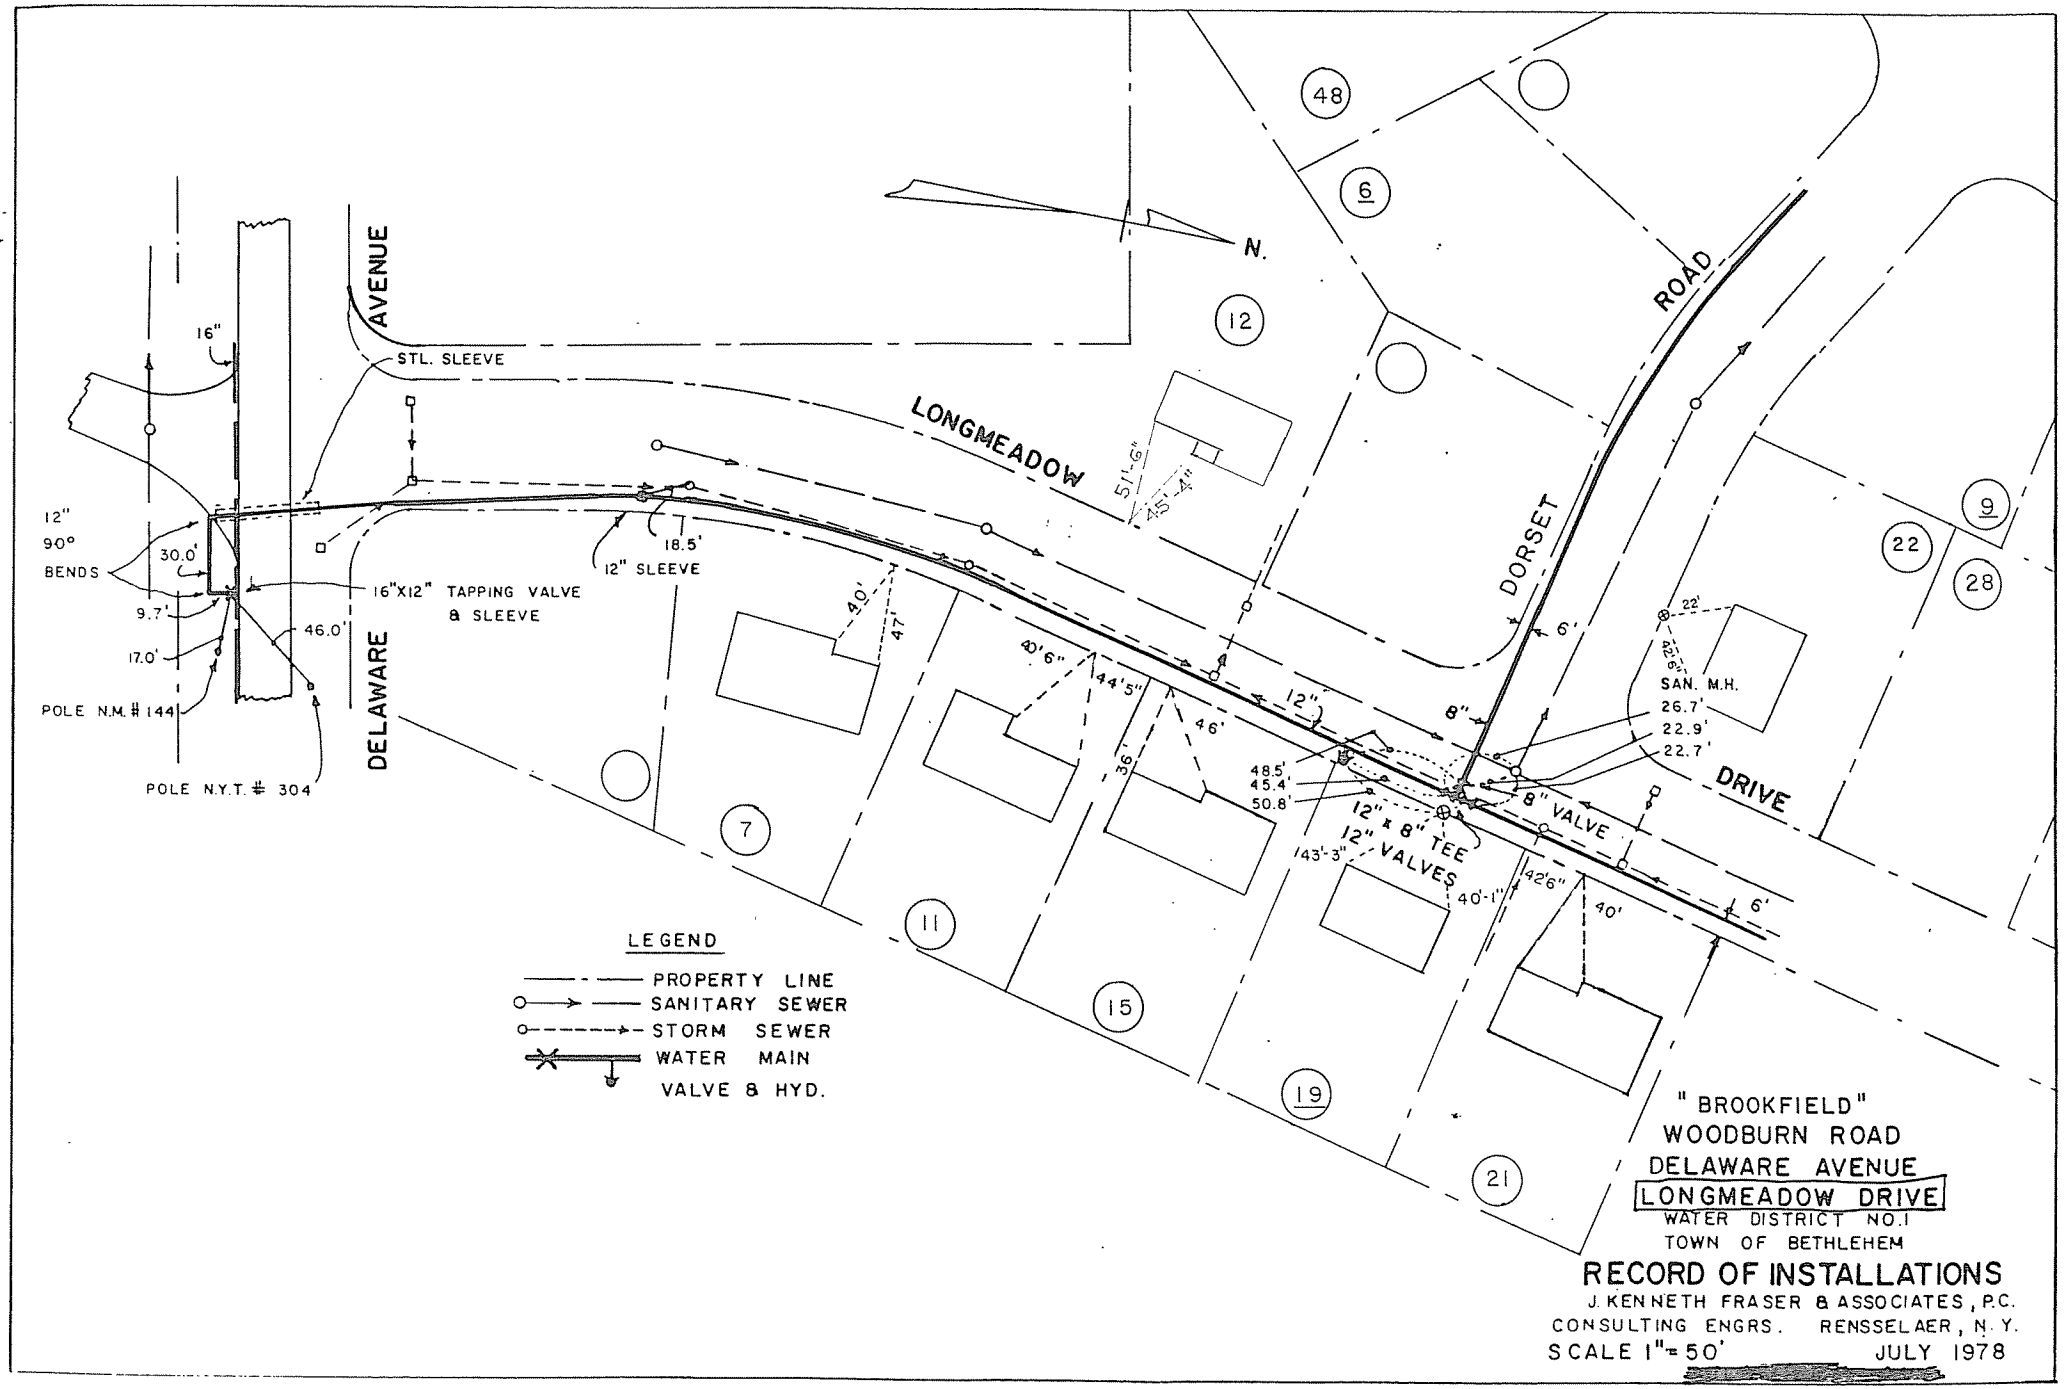
N.
DELAWARE AVENUE
LONGMEADOW
DORSET ROAD
DRIVE
16"
STL. SLEEVE
12" 90° BENDS
30.0'
9.7'
17.0'
46.0'
POLE N.M. # 144
POLE N.Y.T. # 304
16"X12" TAPPING VALVE & SLEEVE
18.5'
12" SLEEVE
51'-6"
45'-4"
40'
47'
40'6"
44'5"
46'
36'
12"
8"
6'
22'
22'6"
SAN. M.H.
26.7'
22.9'
22.7'
48.5'
45.4'
50.8'
12" x 8" TEE
12" VALVES
143'-3"
40'-1"
42'6"
40'
8" VALVE
6'
48
6
12
9
22
28
7
11
15
19
21
LEGEND
PROPERTY LINE
SANITARY SEWER
STORM SEWER
WATER MAIN
VALVE & HYD.
"BROOKFIELD"
WOODBURN ROAD
DELAWARE AVENUE
LONGMEADOW DRIVE
WATER DISTRICT NO.1
TOWN OF BETHLEHEM
RECORD OF INSTALLATIONS
J. KENNETH FRASER & ASSOCIATES, P.C.
CONSULTING ENGRS. RENSSELAER, N.Y.
SCALE 1"=50'
JULY 1978