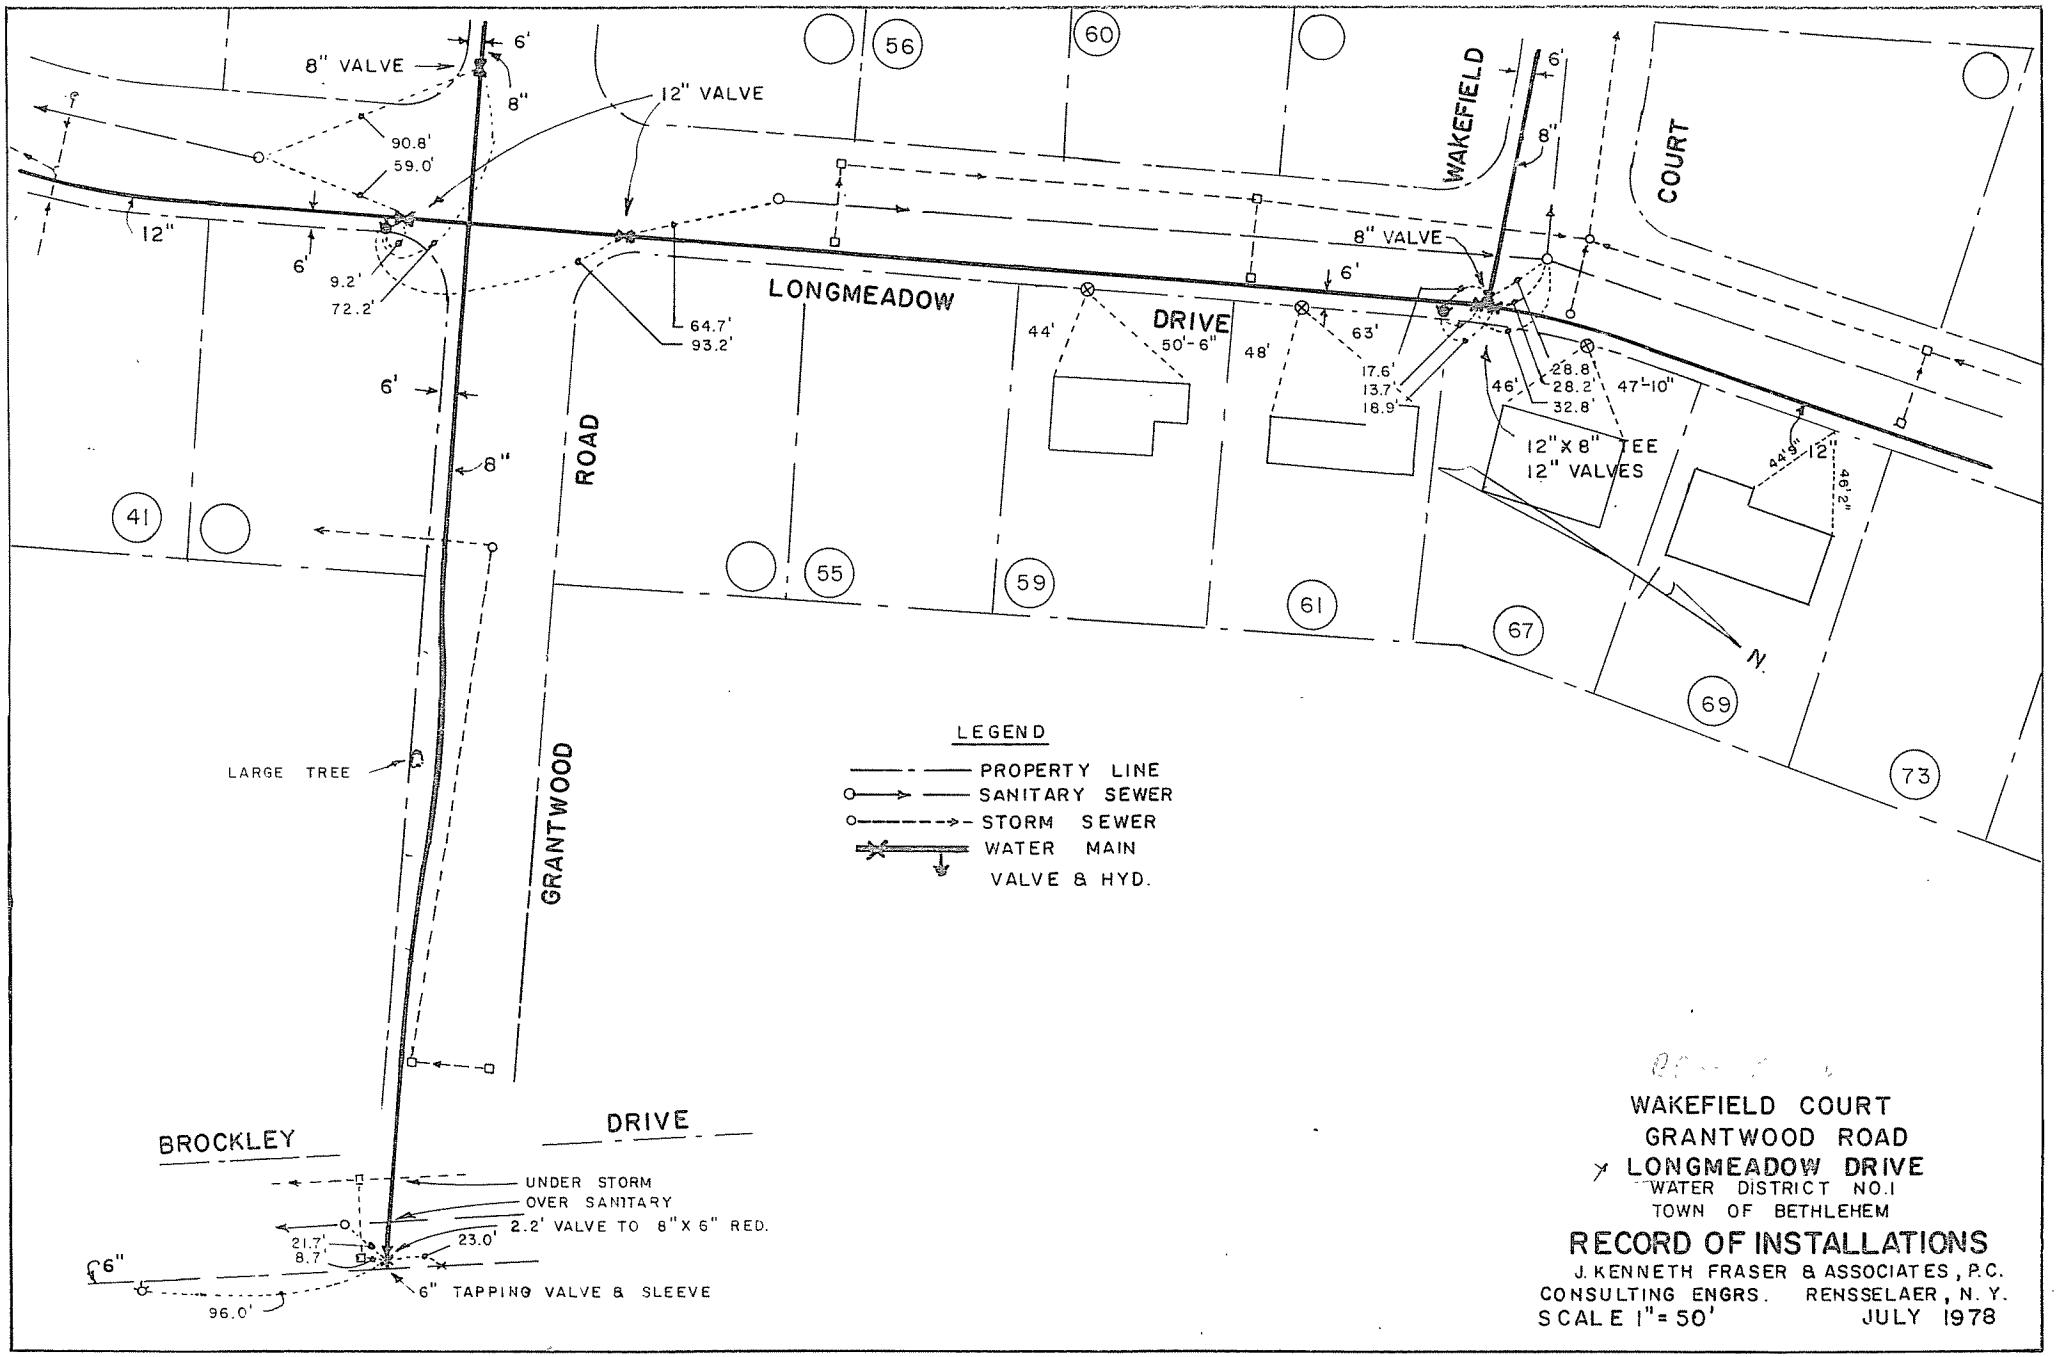

WAKEFIELD COURT
GRANTWOOD ROAD
LONGMEADOW DRIVE
WATER DISTRICT NO.1
TOWN OF BETHLEHEM

RECORD OF INSTALLATIONS

J. KENNETH FRASER & ASSOCIATES, P.C.
CONSULTING ENGRS. RENSSELAER, N. Y.
SCALE 1"= 50' JULY 1978