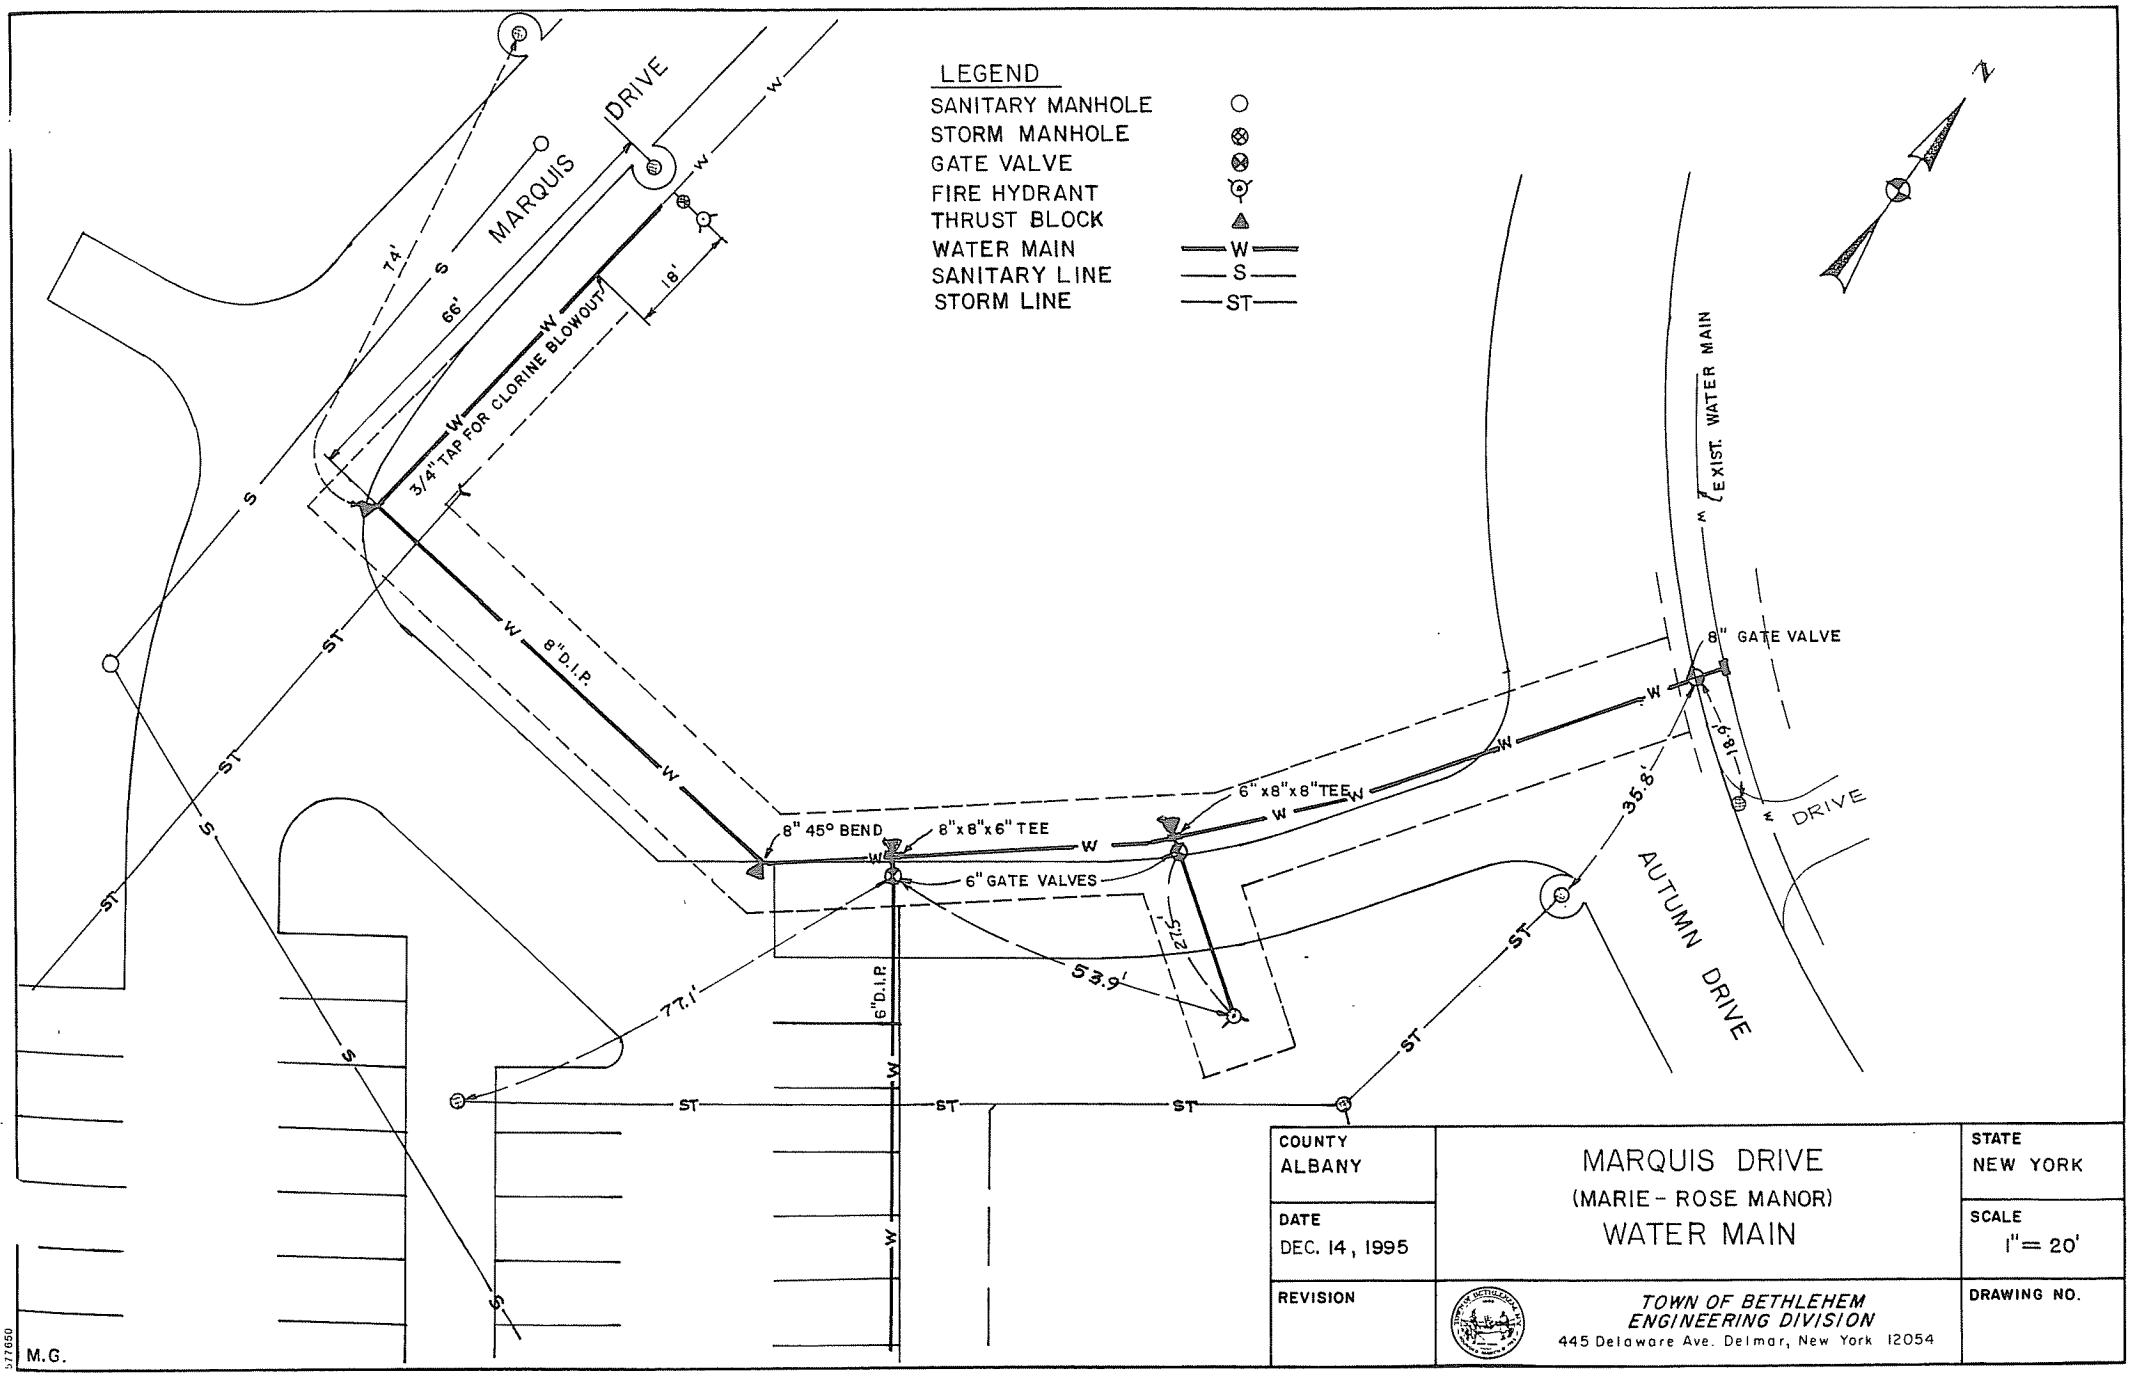

COUNTY ALBANY	MARQUIS DRIVE (MARIE - ROSE MANOR) WATER MAIN	STATE NEW YORK
DATE DEC. 14, 1995		SCALE 1" = 20'
REVISION	TOWN OF BETHLEHEM ENGINEERING DIVISION 445 Delaware Ave. Delmar, New York 12054	DRAWING NO.

M.G.