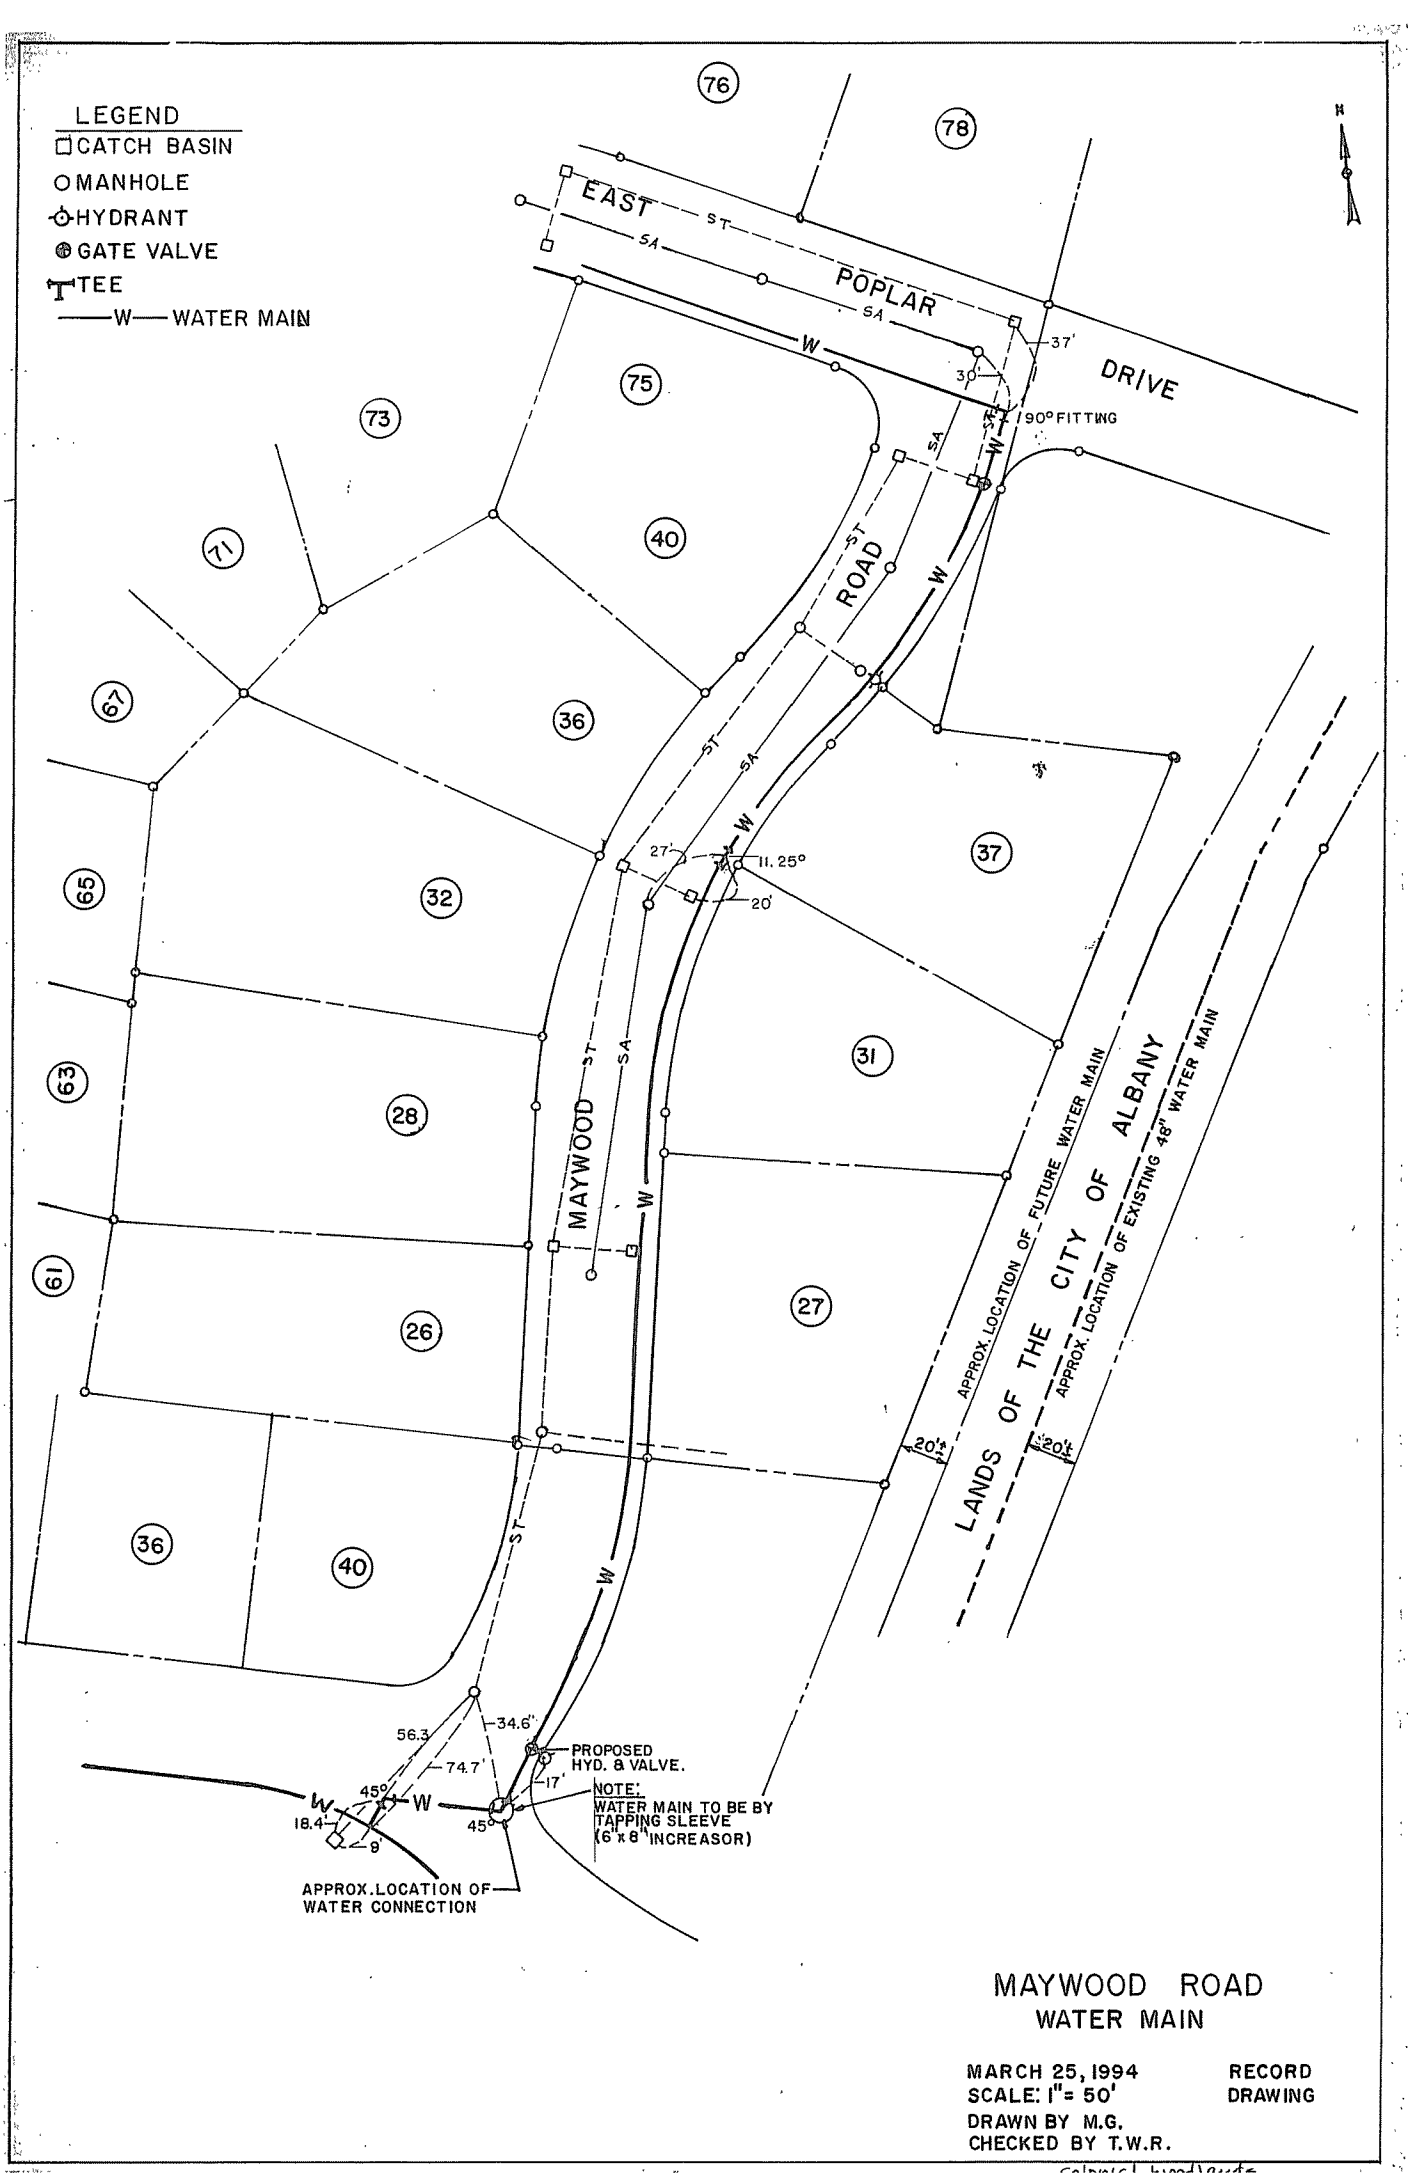
LEGEND
CATCH BASIN
MANHOLE
HYDRANT
GATE VALVE
TEE
W WATER MAIN
EAST POPLAR DRIVE
MAYWOOD ROAD
LANDS OF THE CITY OF ALBANY
APPROX. LOCATION OF FUTURE WATER MAIN
APPROX. LOCATION OF EXISTING 48" WATER MAIN
90° FITTING
PROPOSED HYD. & VALVE.
NOTE: WATER MAIN TO BE BY TAPPING SLEEVE (6" x 8" INCREASOR)
APPROX. LOCATION OF WATER CONNECTION
MAYWOOD ROAD
WATER MAIN
MARCH 25, 1994
SCALE: 1" = 50'
DRAWN BY M.G.
CHECKED BY T.W.R.
RECORD DRAWING