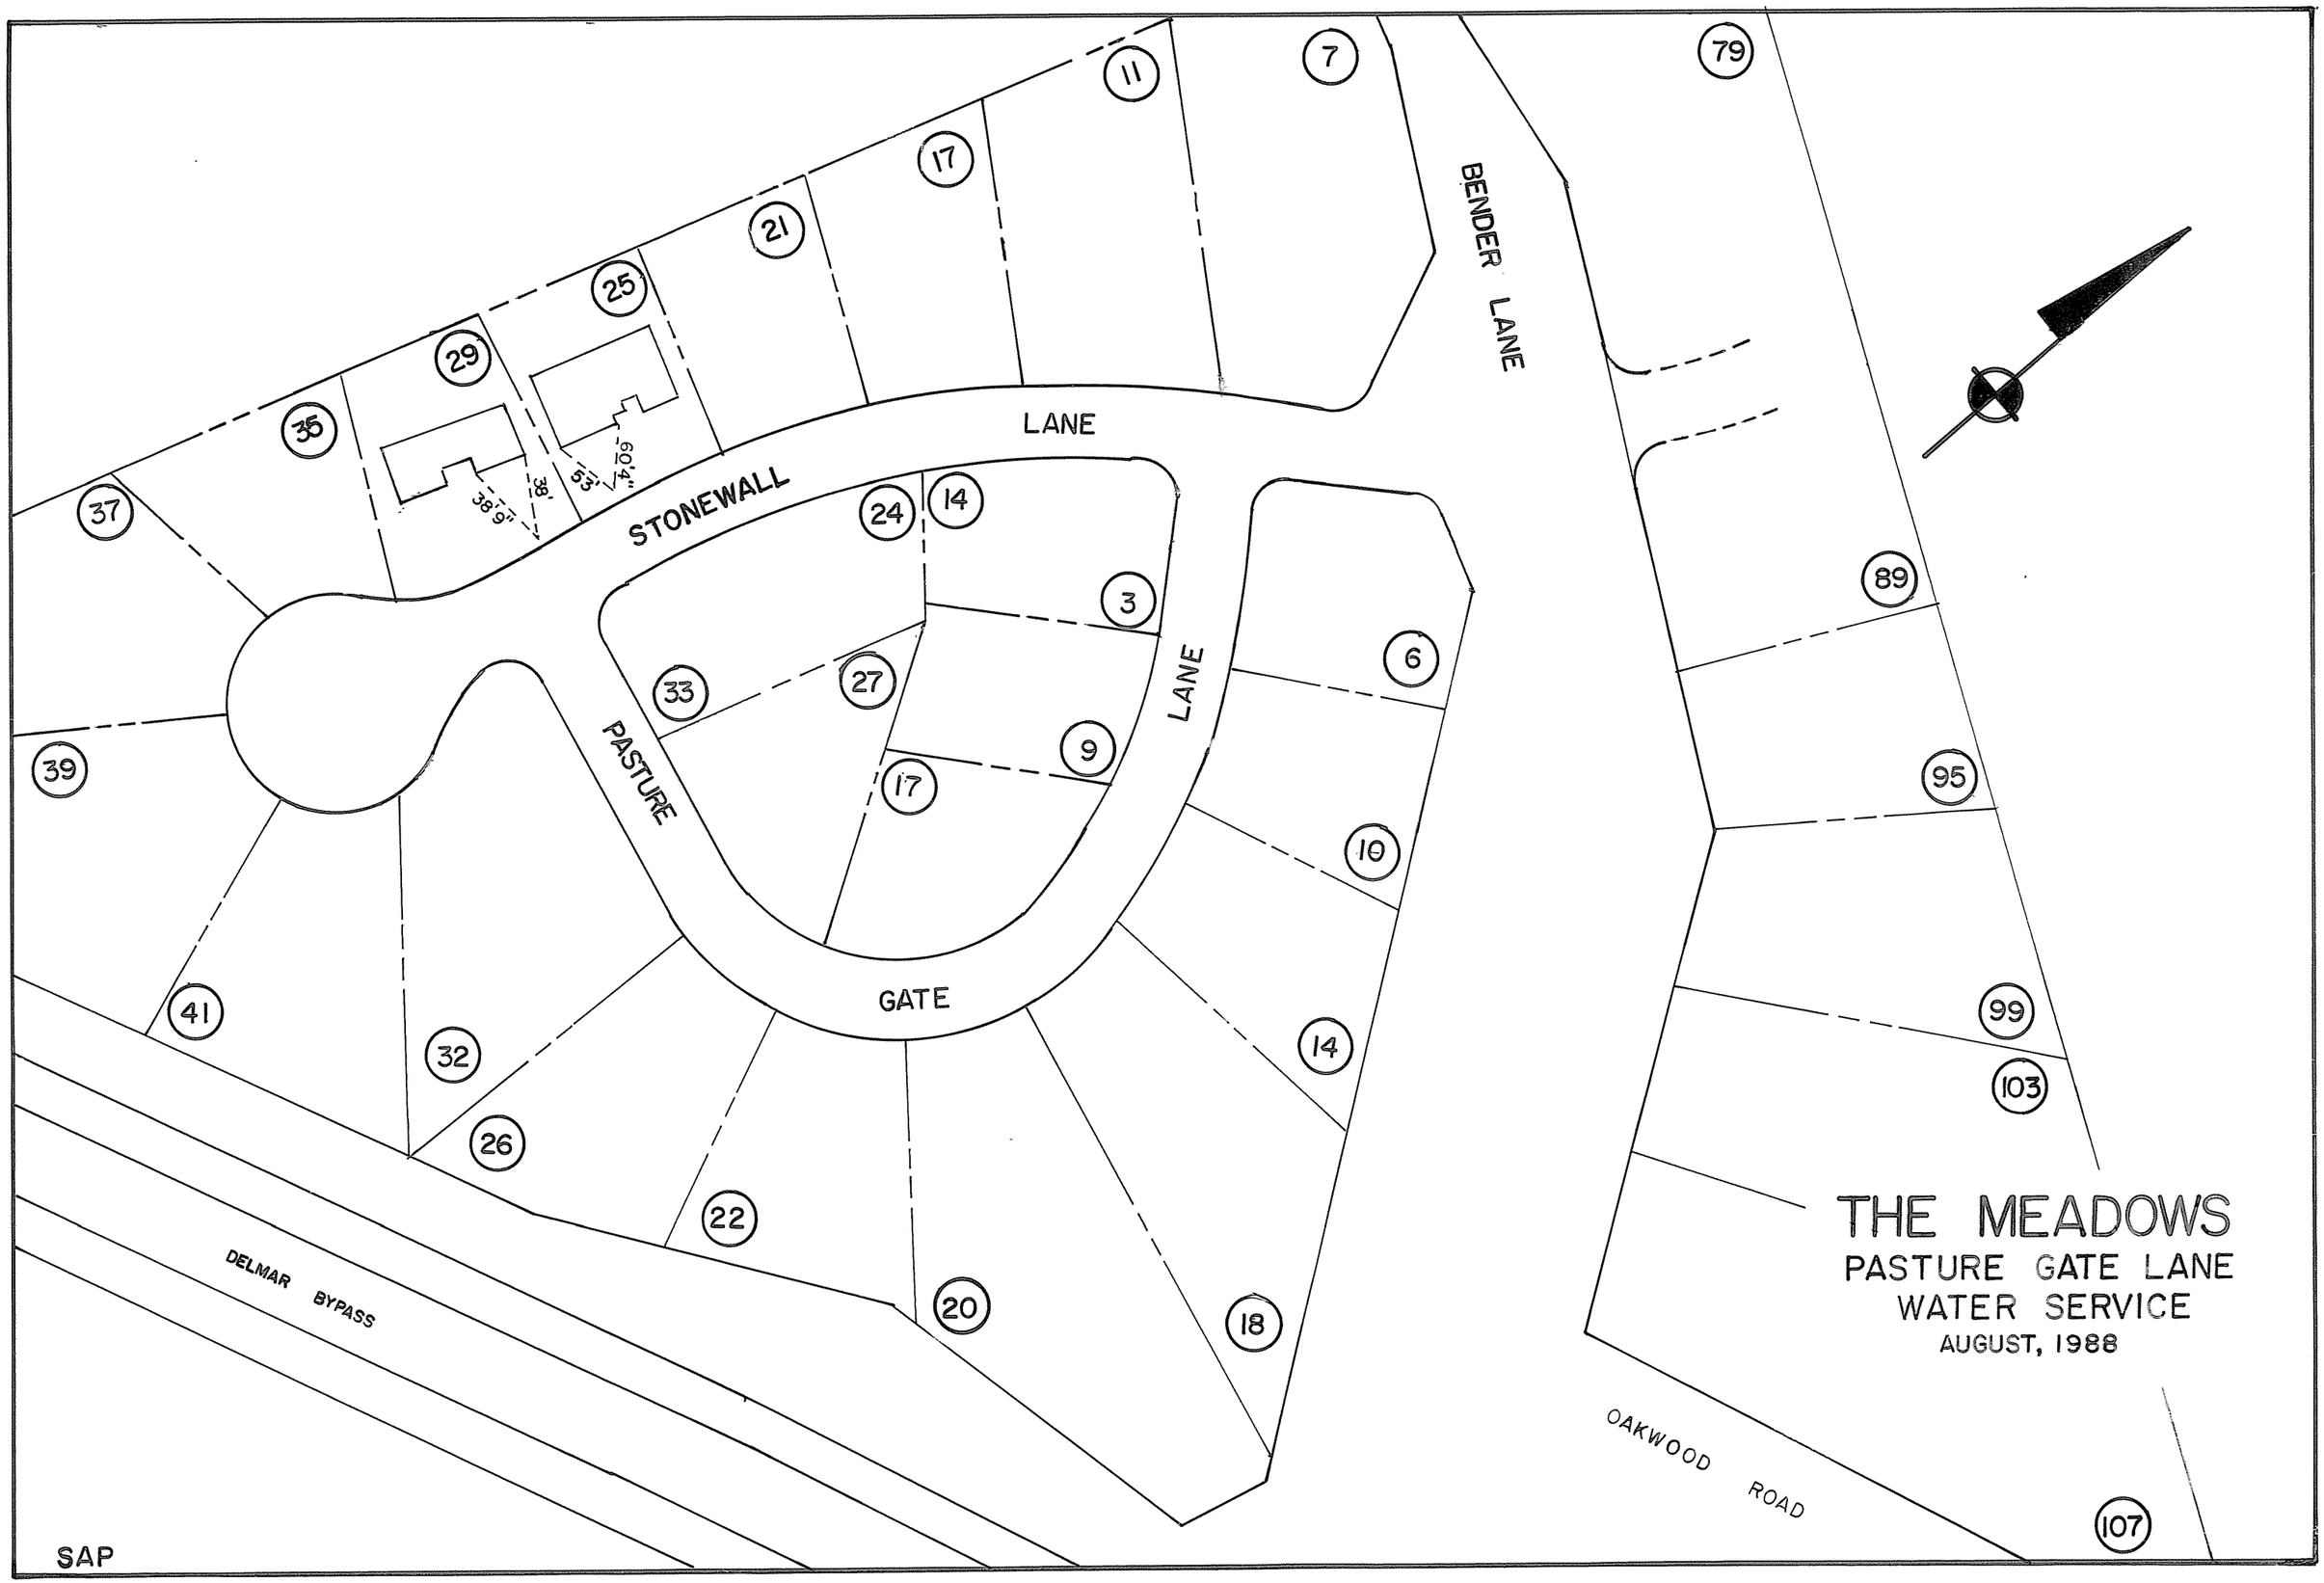
THE MEADOWS
PASTURE GATE LANE
WATER SERVICE
AUGUST, 1988
STONEWALL
LANE
BENDER LANE
PASTURE
LANE
GATE
DELMAR BYPASS
OAKWOOD ROAD
38'9"
38'
53'
60'4"
11
7
79
17
21
25
29
35
37
24
14
3
33
27
9
17
6
10
14
89
95
99
103
39
41
32
26
22
20
18
107
SAP