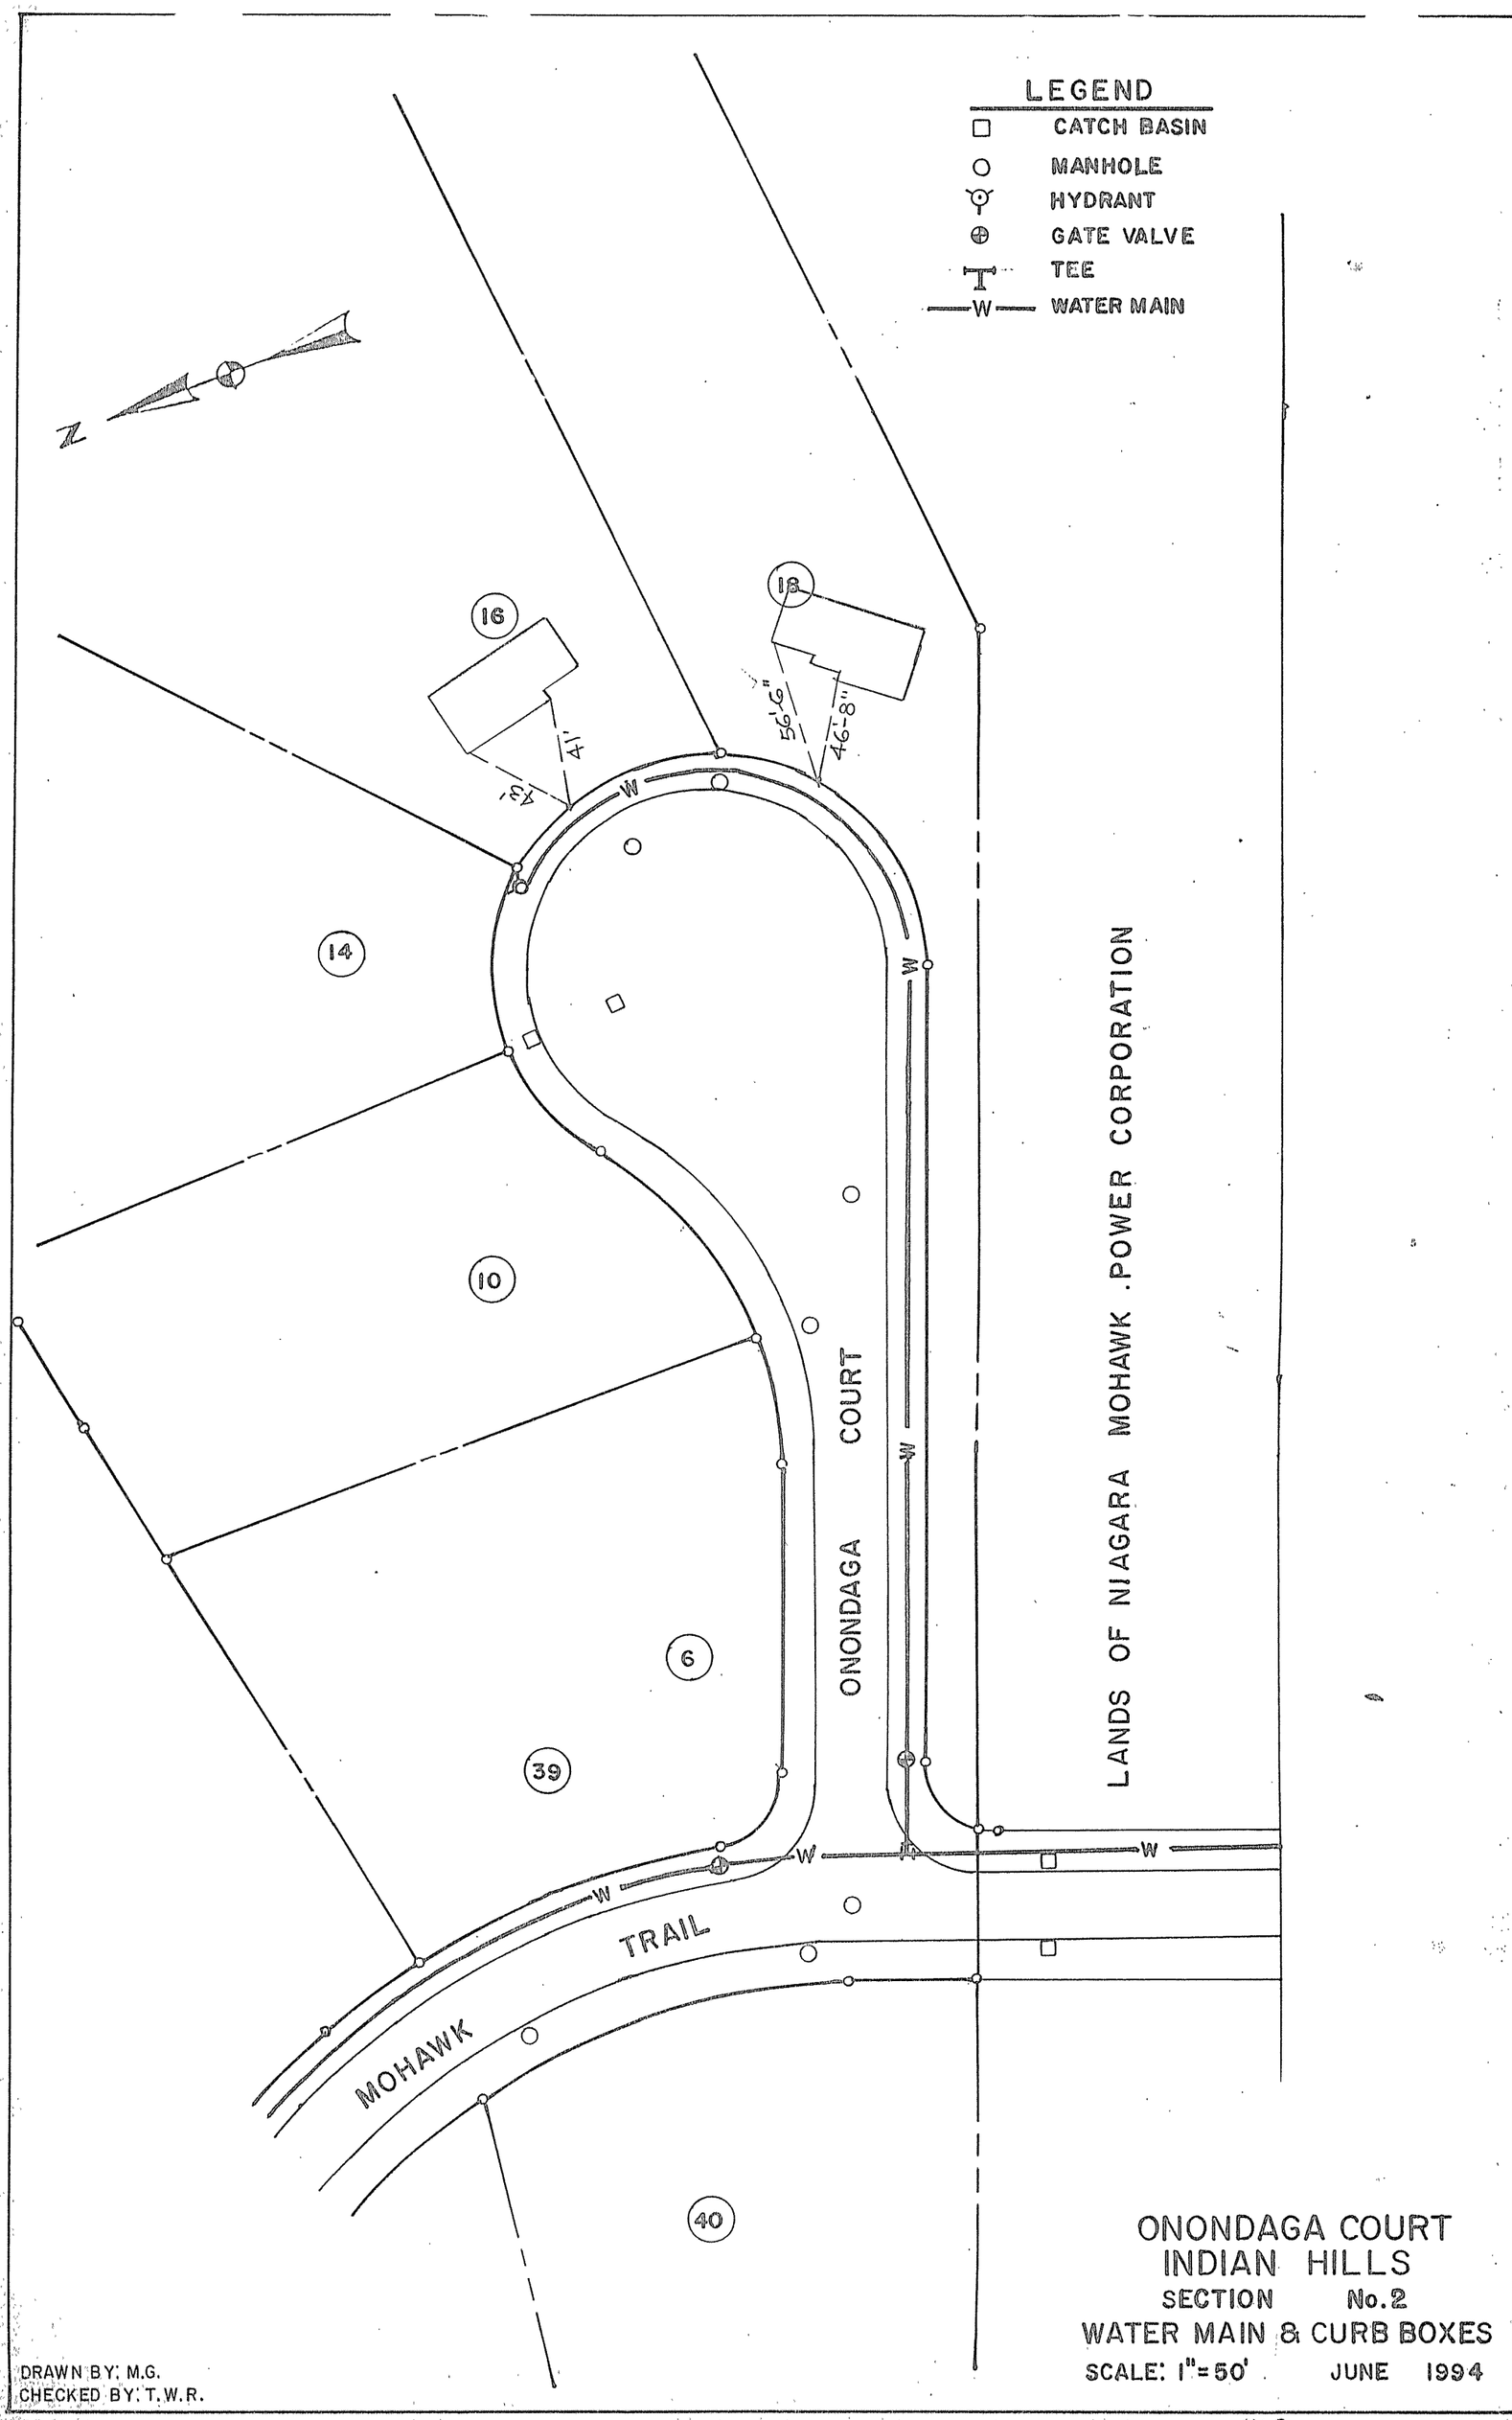
LEGEND
CATCH BASIN
MANHOLE
HYDRANT
GATE VALVE
TEE
WATER MAIN
N
16
18
14
10
6
39
40
41'
43'
56'-6"
46'-8"
W
ONONDAGA COURT
LANDS OF NIAGARA MOHAWK POWER CORPORATION
MOHAWK TRAIL
ONONDAGA COURT
INDIAN HILLS
SECTION No. 2
WATER MAIN & CURB BOXES
SCALE: 1"=50'
JUNE 1994
DRAWN BY: M.G.
CHECKED BY: T.W.R.