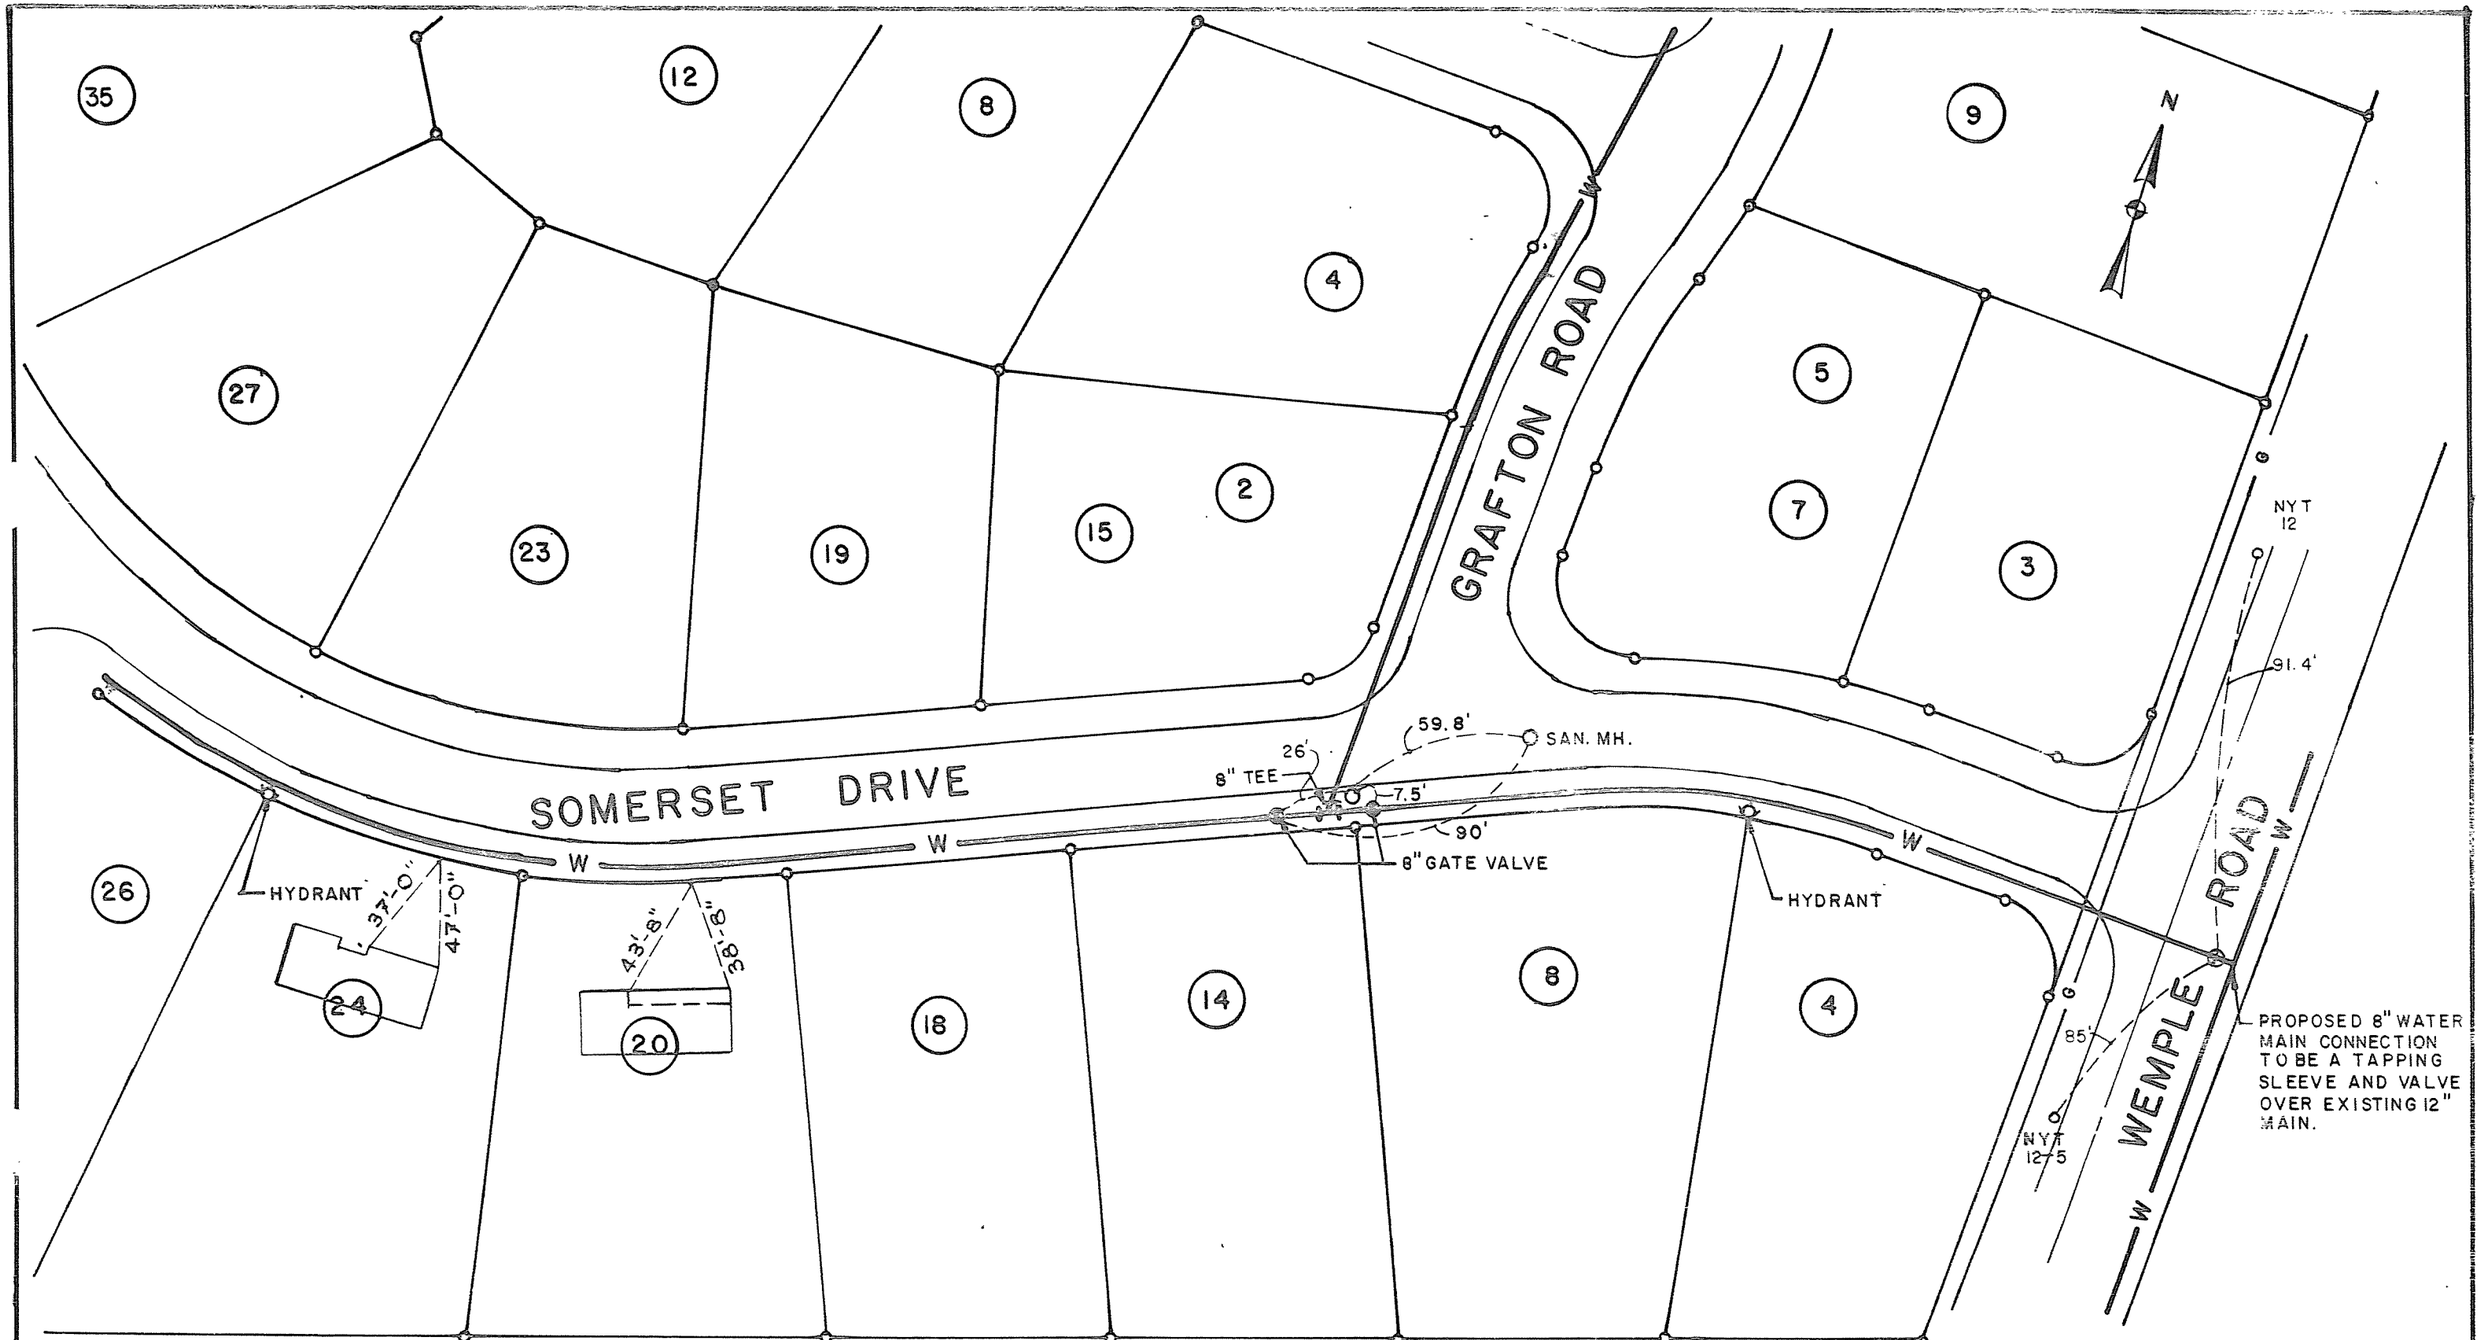

SOMERSET WOODS

WATER MAIN & CURB BOXES

DRAWN BY MG.
CHECKED BY DMS.

AUG. 31, 1990
SCALE: 1"=50'

RECORD DRAWING