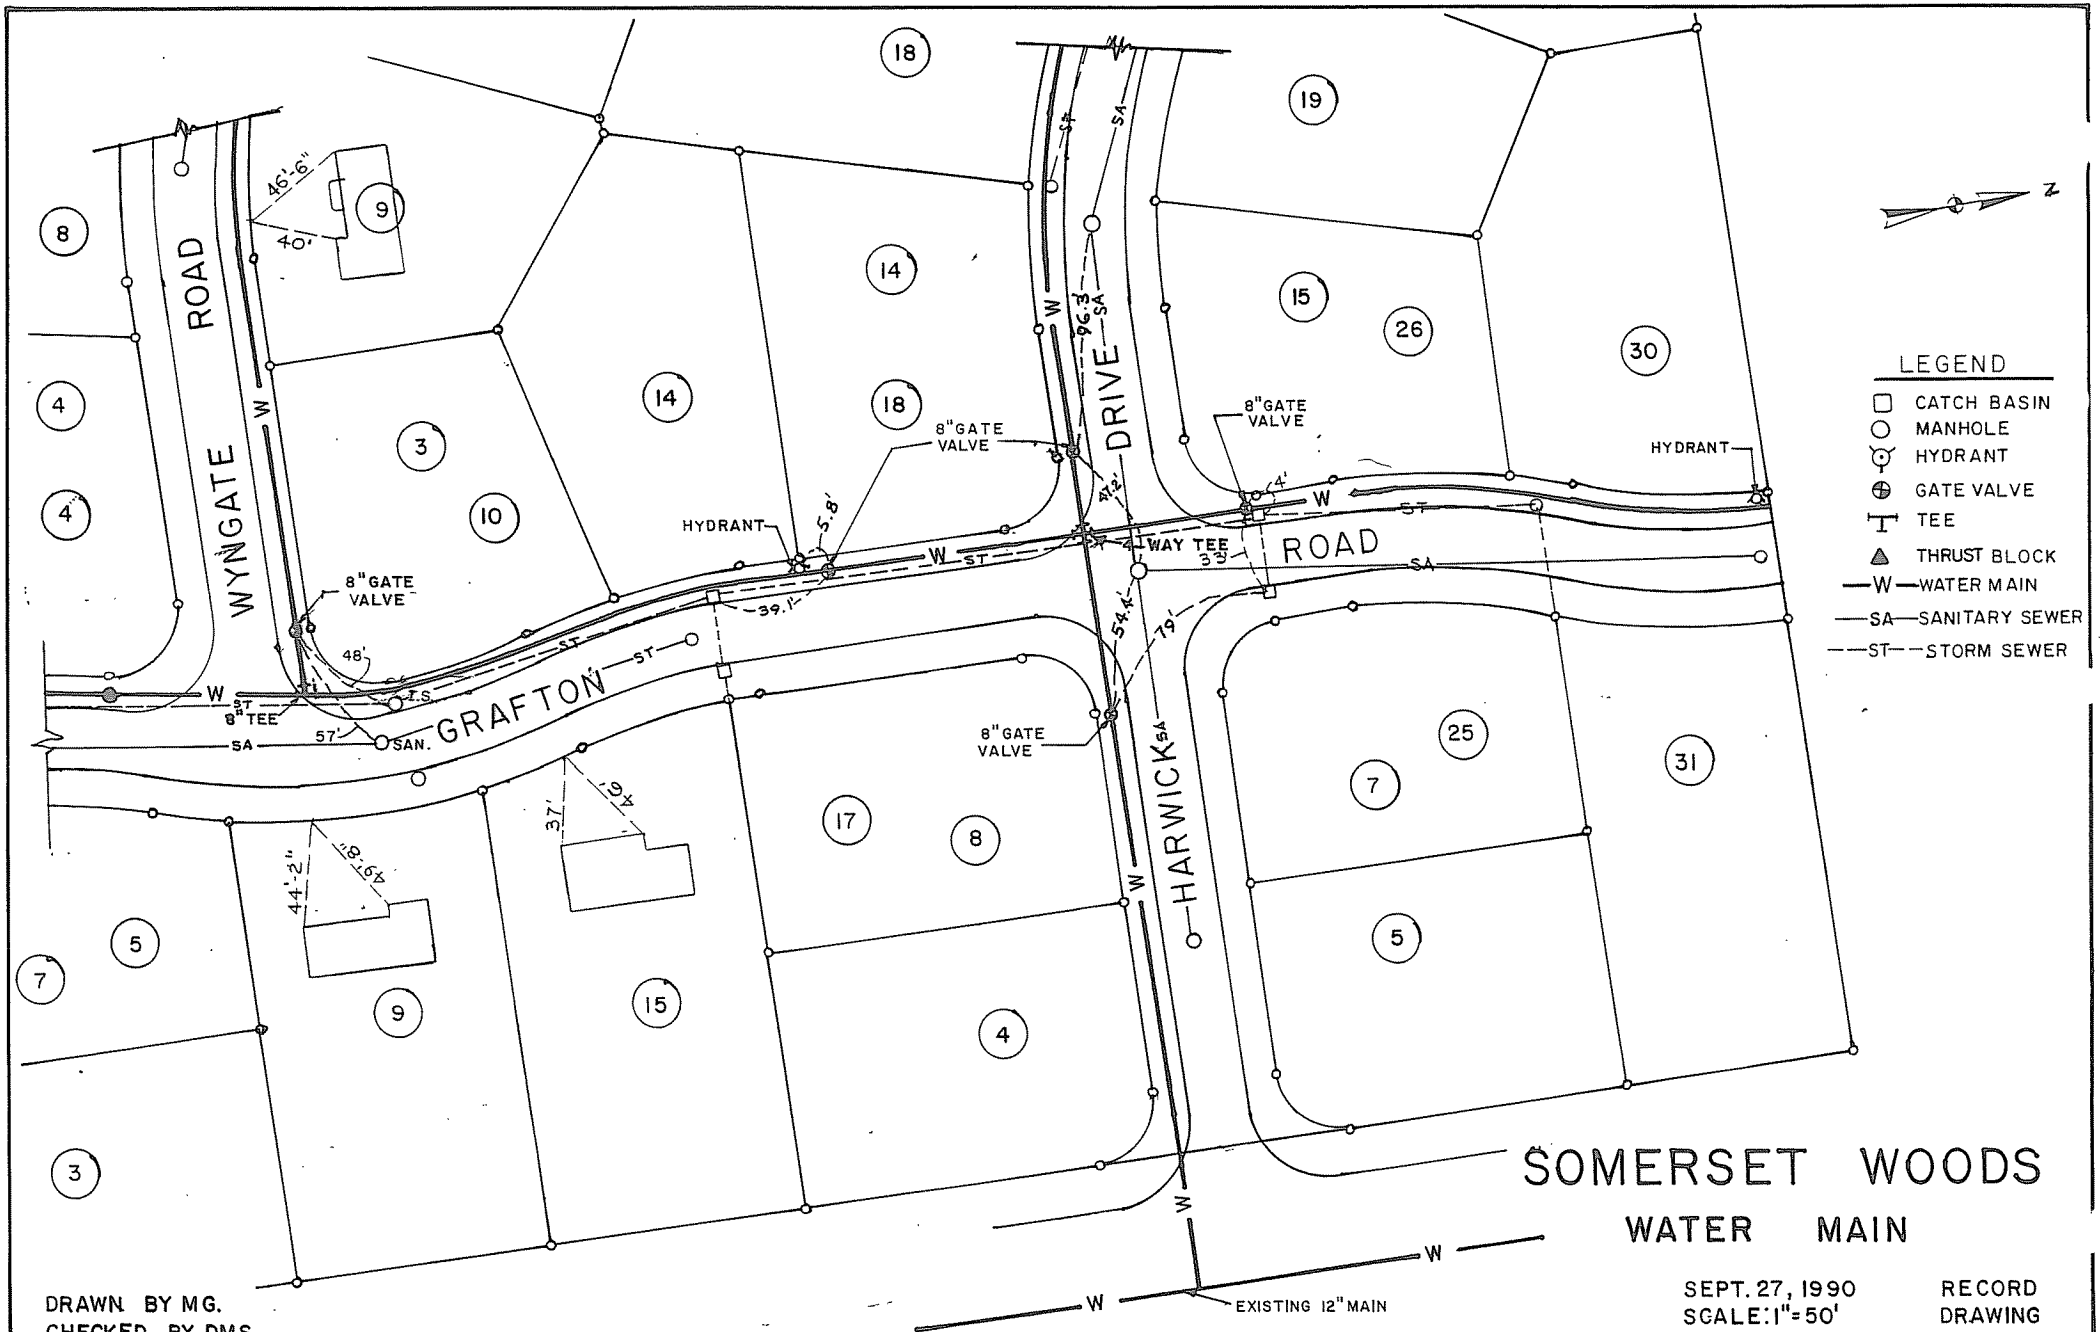
WYNGATE ROAD
GRAFTON ROAD
HARWICK DRIVE
8" GATE VALVE
HYDRANT
8" TEE
T.S.
SAN.
4 WAY TEE
EXISTING 12" MAIN
LEGEND
CATCH BASIN
MANHOLE
HYDRANT
GATE VALVE
TEE
THRUST BLOCK
—W— WATER MAIN
—SA— SANITARY SEWER
—ST— STORM SEWER
SOMERSET WOODS
WATER MAIN
SEPT. 27, 1990
SCALE: 1" = 50'
RECORD DRAWING
DRAWN BY MG.
CHECKED BY DMS.