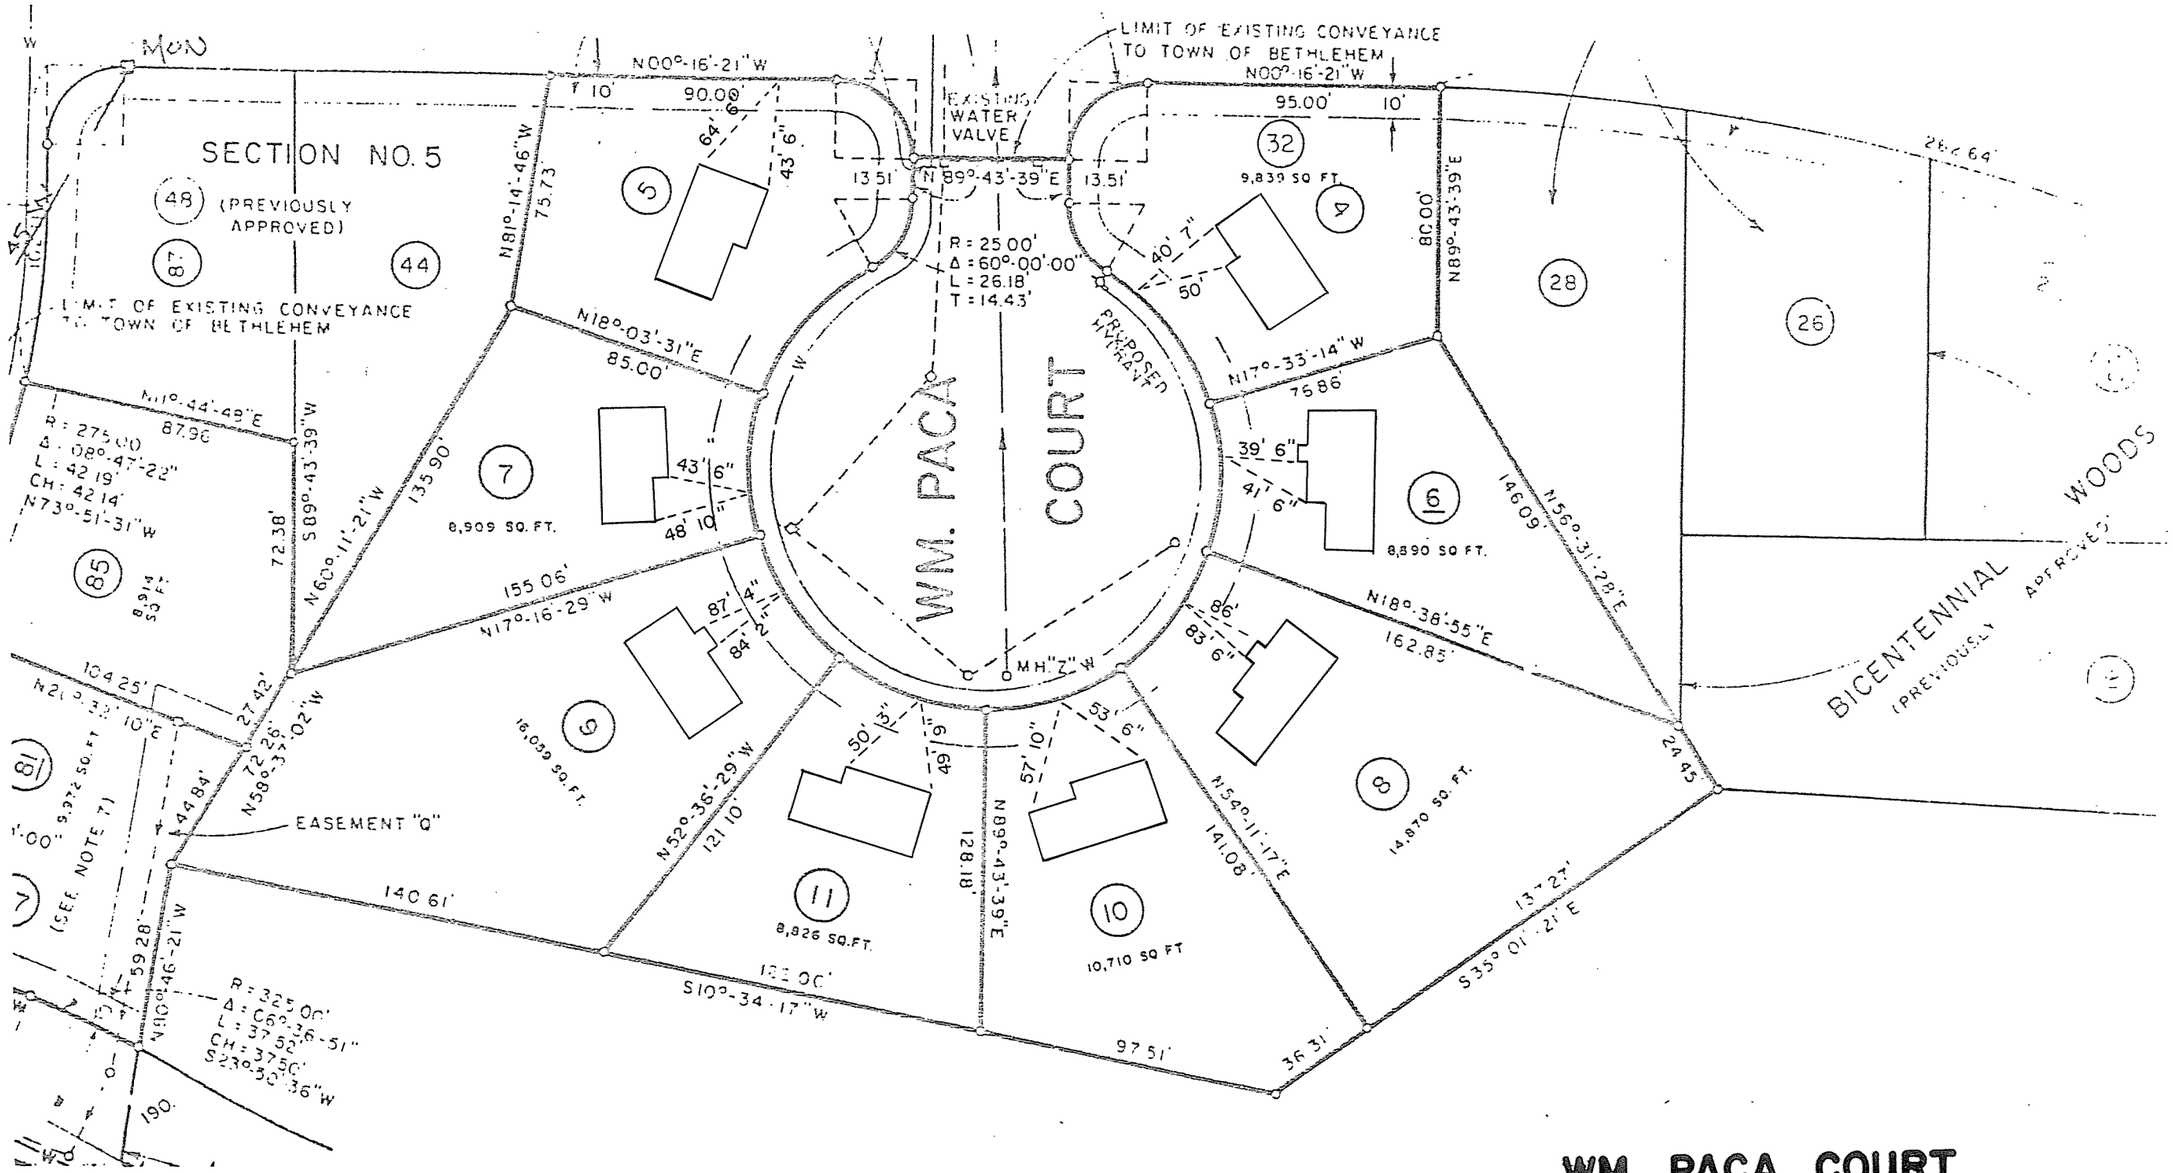

WM PACA COURT