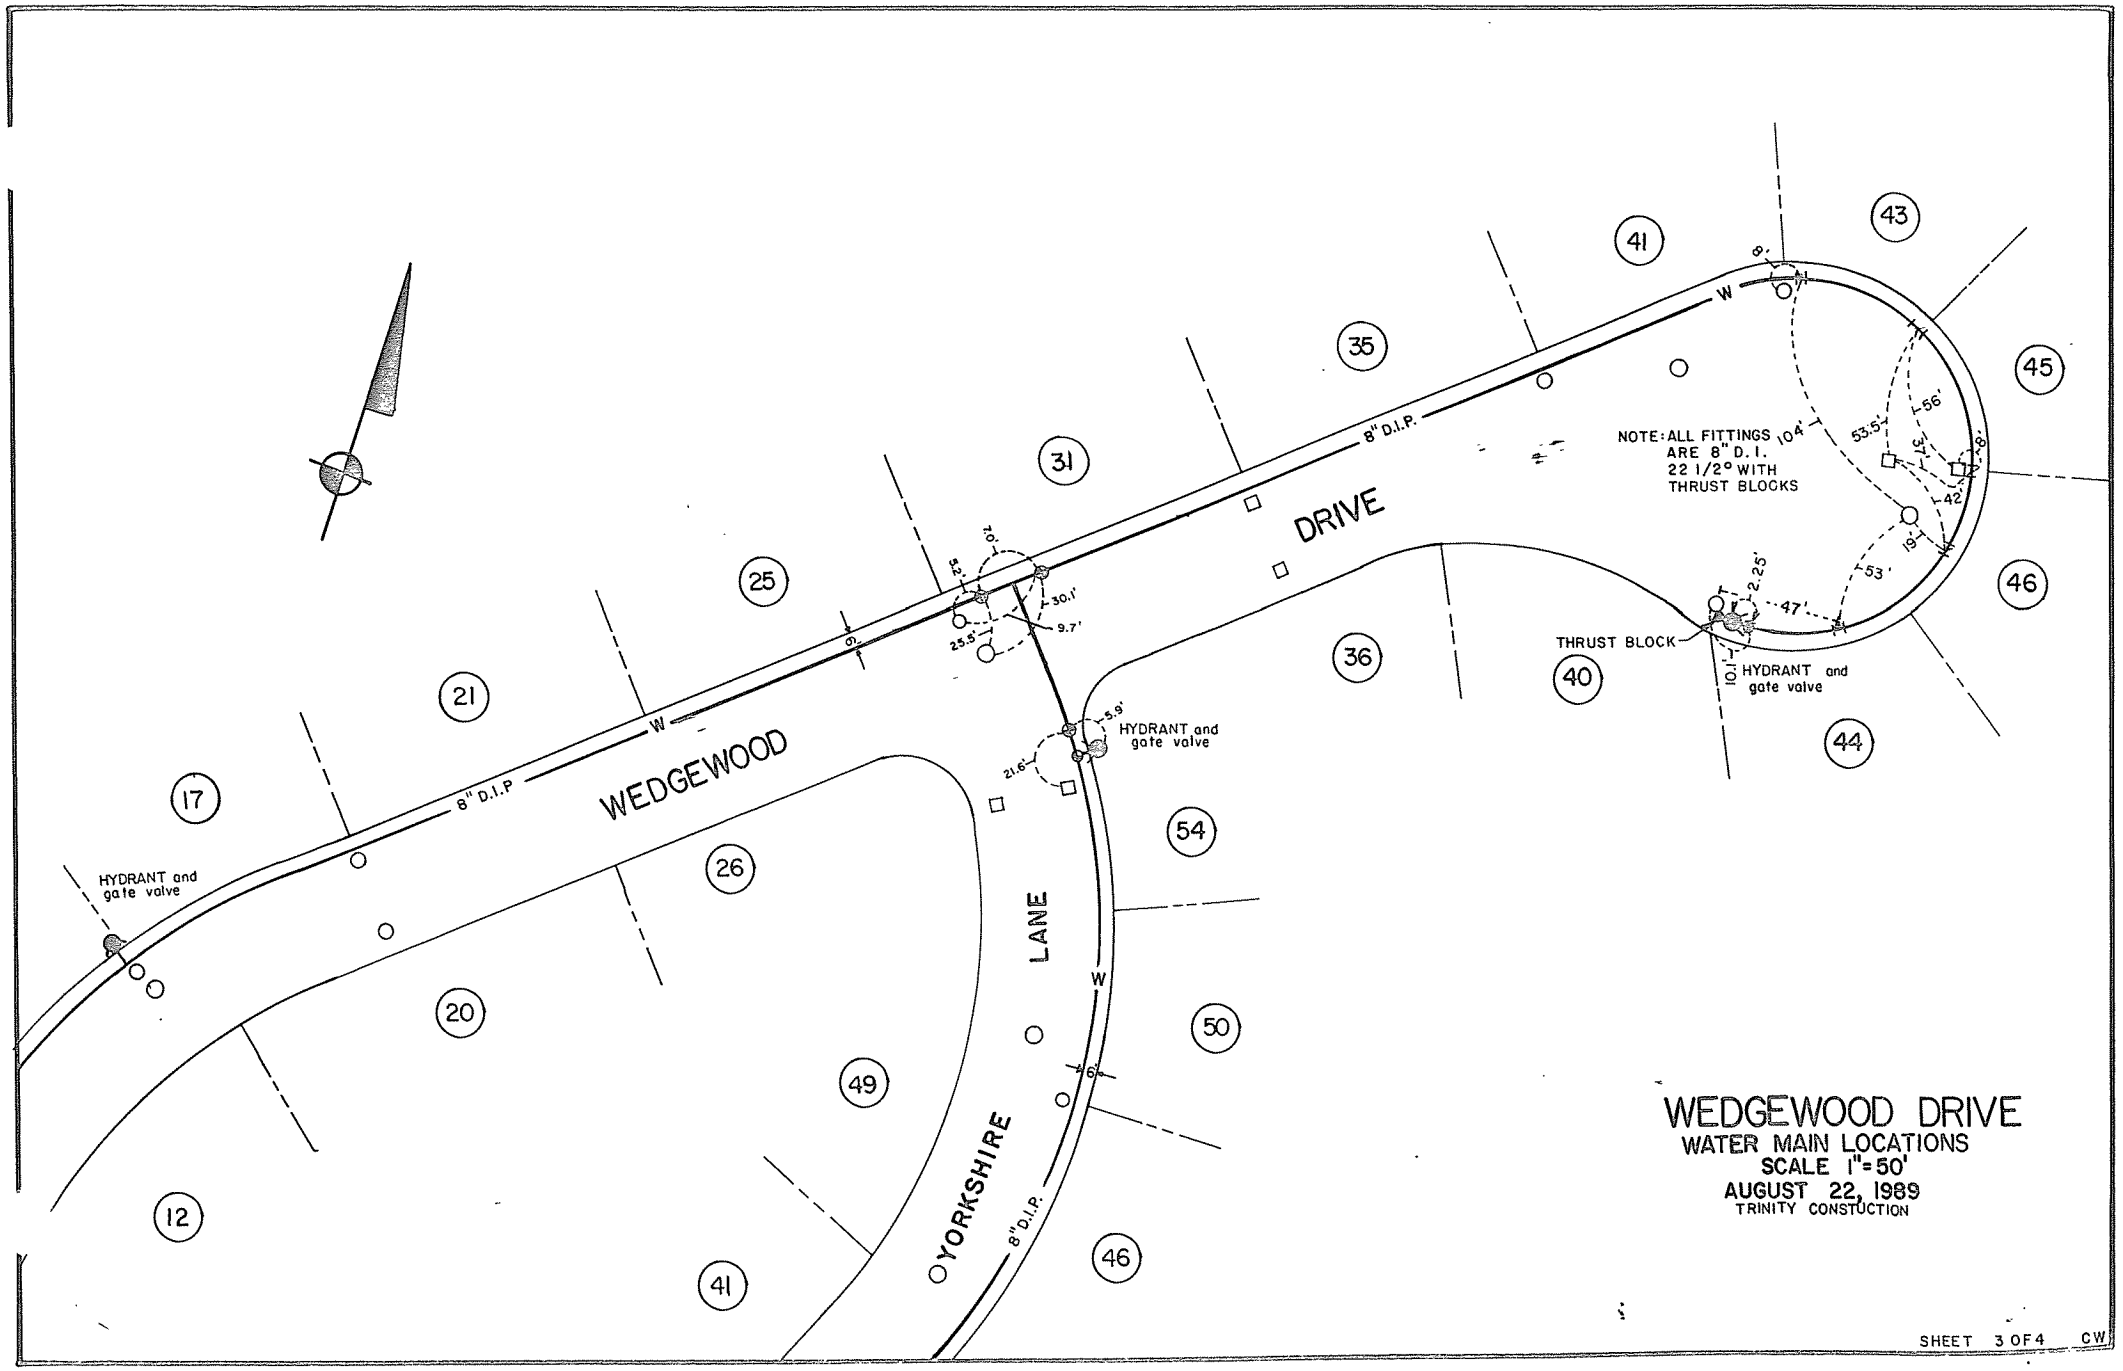
WEDGEWOOD DRIVE
WATER MAIN LOCATIONS
SCALE 1"=50'
AUGUST 22, 1989
TRINITY CONSTUCTION
WEDGEWOOD
DRIVE
YORKSHIRE
LANE
8" D.I.P.
W
HYDRANT and gate valve
THRUST BLOCK
NOTE: ALL FITTINGS ARE 8" D.I. 22 1/2° WITH THRUST BLOCKS
17
21
25
31
35
41
43
45
46
12
20
26
49
41
54
50
46
36
40
44
7.0'
5.2'
30.1'
9.7'
25.5'
5.5'
21.6'
6'
9'
104'
53.5'
56'
47'
42'
8'
19'
53'
2.25'
47'
10.1'
SHEET 3 OF 4 CW