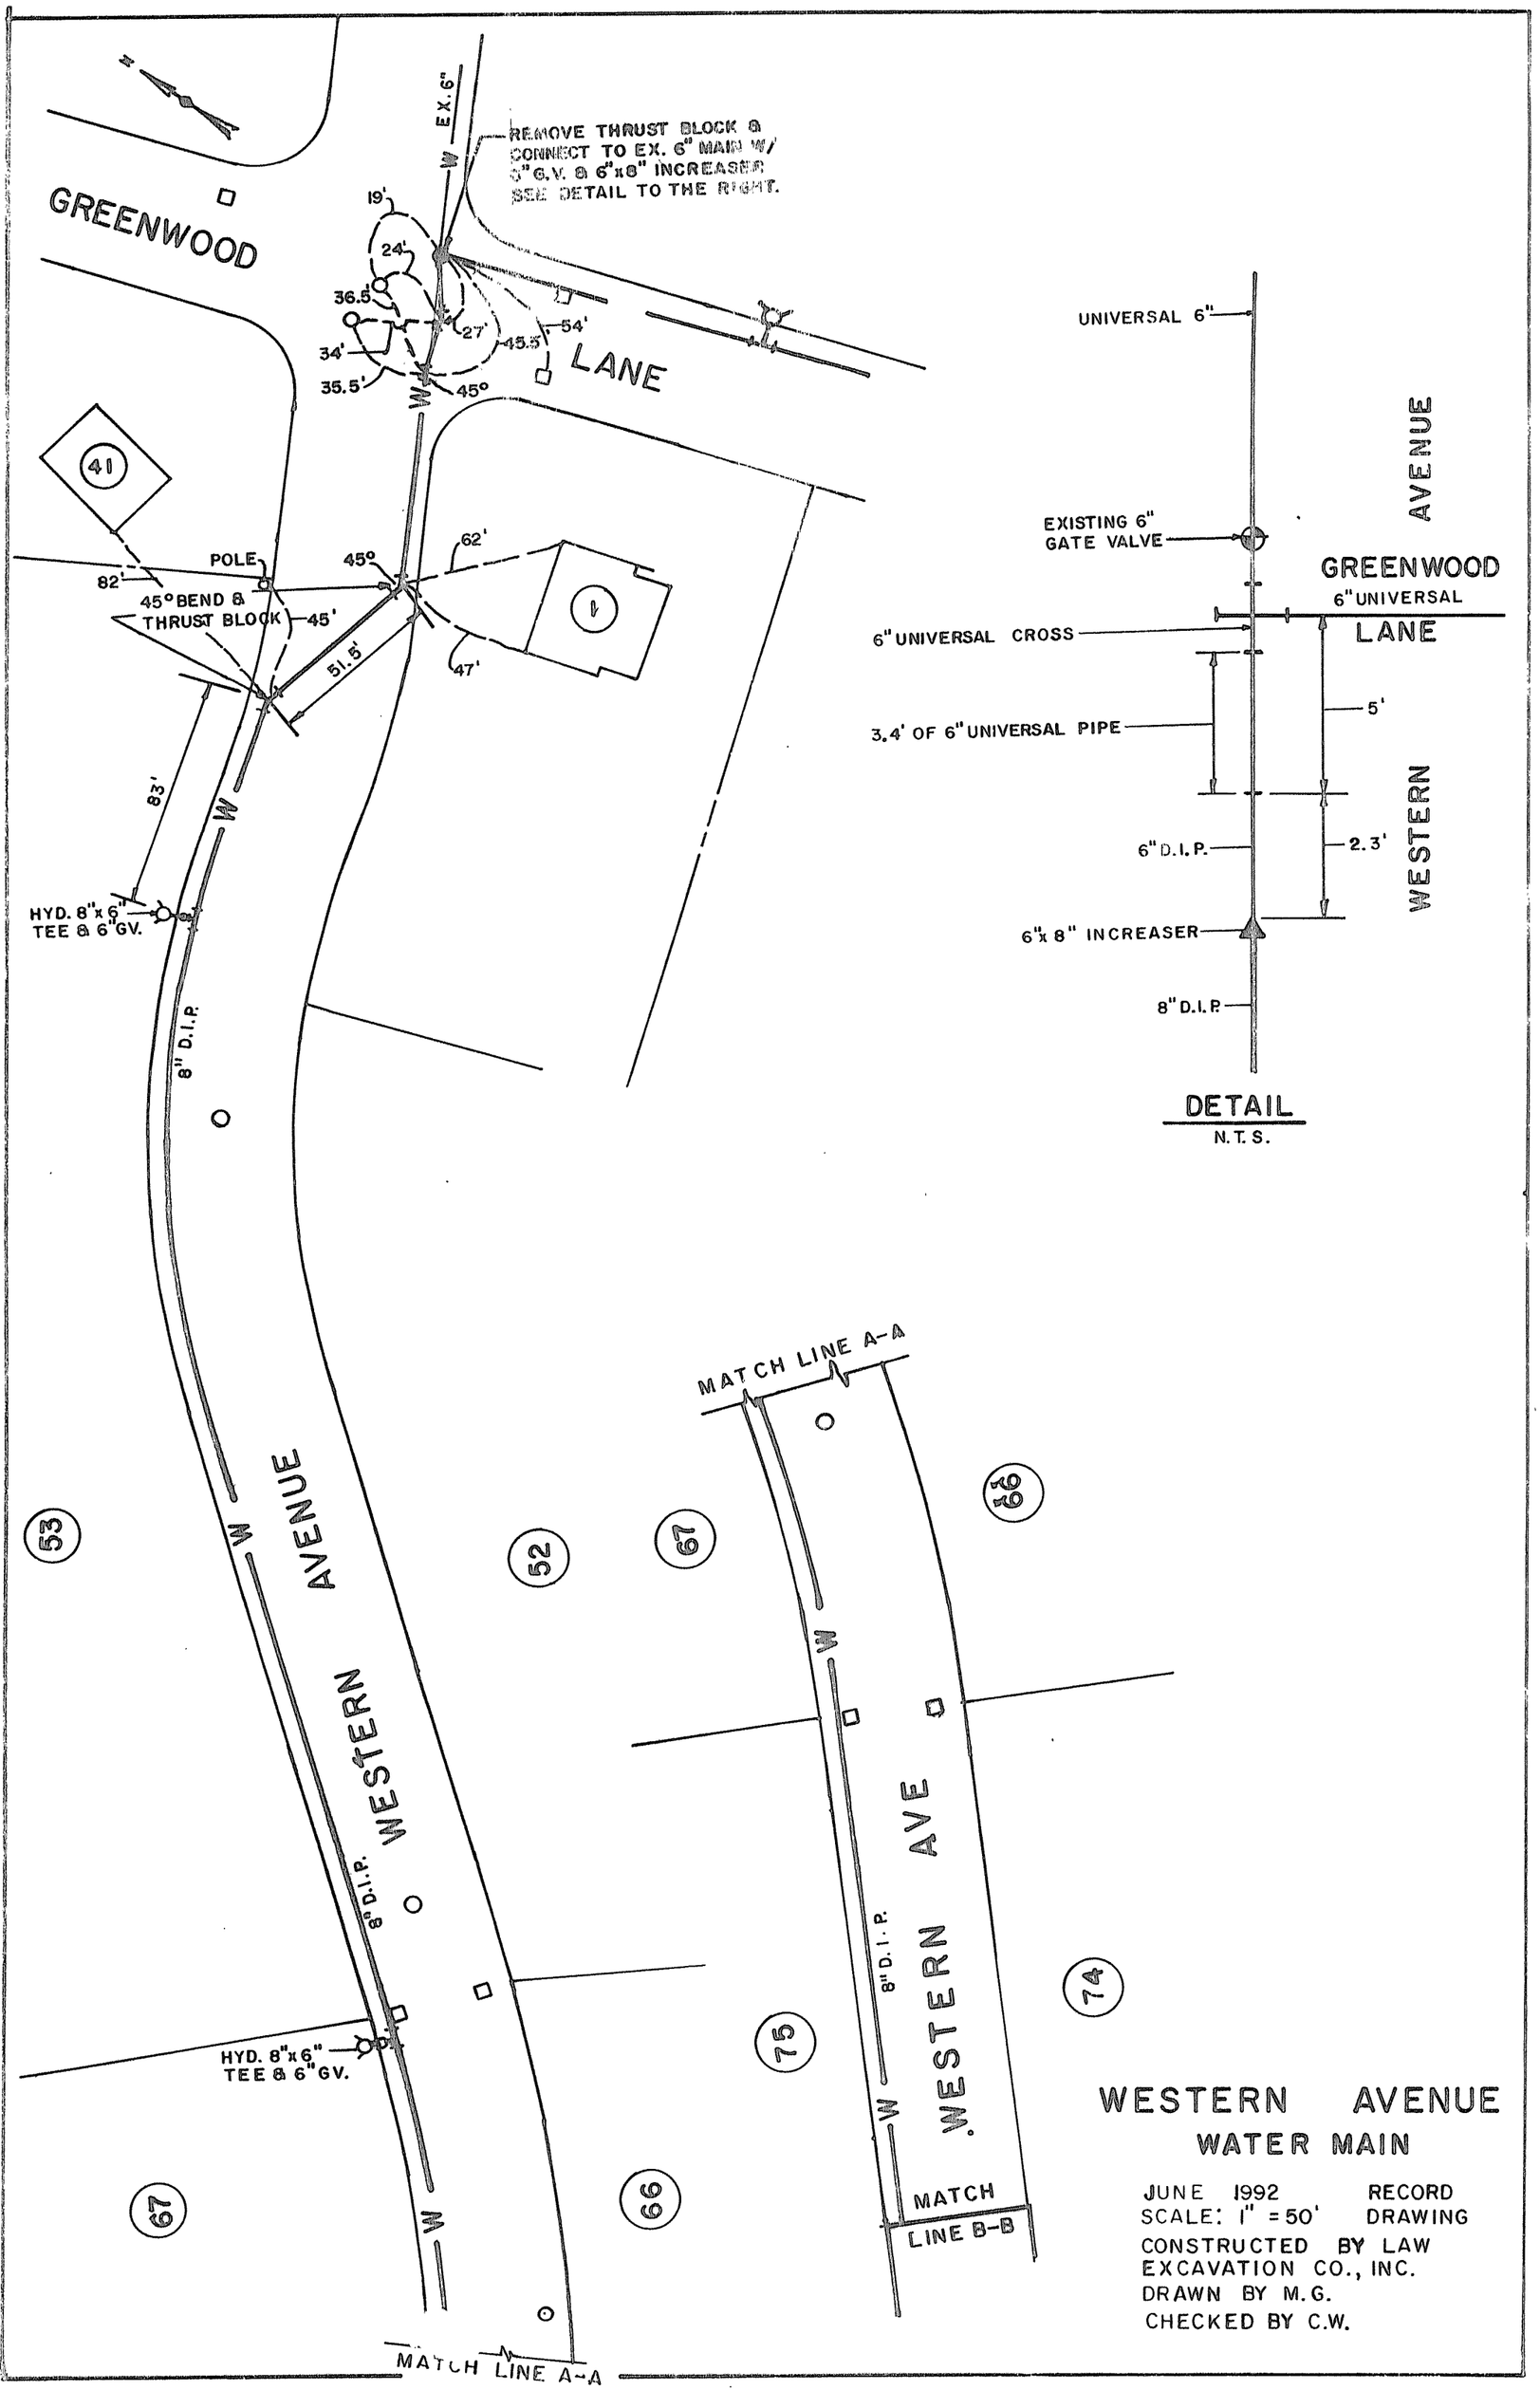
GREENWOOD
LANE
EX. 6"
REMOVE THRUST BLOCK & CONNECT TO EX. 6" MAIN W/ 3" G.V. & 6"x8" INCREASER SEE DETAIL TO THE RIGHT.
19'
24'
36.5'
27'
54'
45.5'
34'
35.5'
45°
41
POLE
82'
45° BEND & THRUST BLOCK
45'
45°
62'
51.5'
47'
1
83'
HYD. 8"x6" TEE & 6" GV.
8" D.I.P.
UNIVERSAL 6"
EXISTING 6" GATE VALVE
GREENWOOD AVENUE
6" UNIVERSAL
6" UNIVERSAL CROSS
LANE
3.4' OF 6" UNIVERSAL PIPE
5'
WESTERN
6" D.I.P.
2.3'
6"x 8" INCREASER
8" D.I.P.
DETAIL
N.T.S.
MATCH LINE A-A
53
52
67
66
WESTERN AVENUE
8" D.I.P.
HYD. 8"x6" TEE & 6" GV.
WESTERN AVE
8" D.I.P.
75
74
67
66
MATCH LINE B-B
MATCH LINE A-A
WESTERN AVENUE
WATER MAIN
JUNE 1992
SCALE: 1" = 50'
RECORD DRAWING
CONSTRUCTED BY LAW EXCAVATION CO., INC.
DRAWN BY M.G.
CHECKED BY C.W.